


T. 1 N., R. 16 E. W. M.

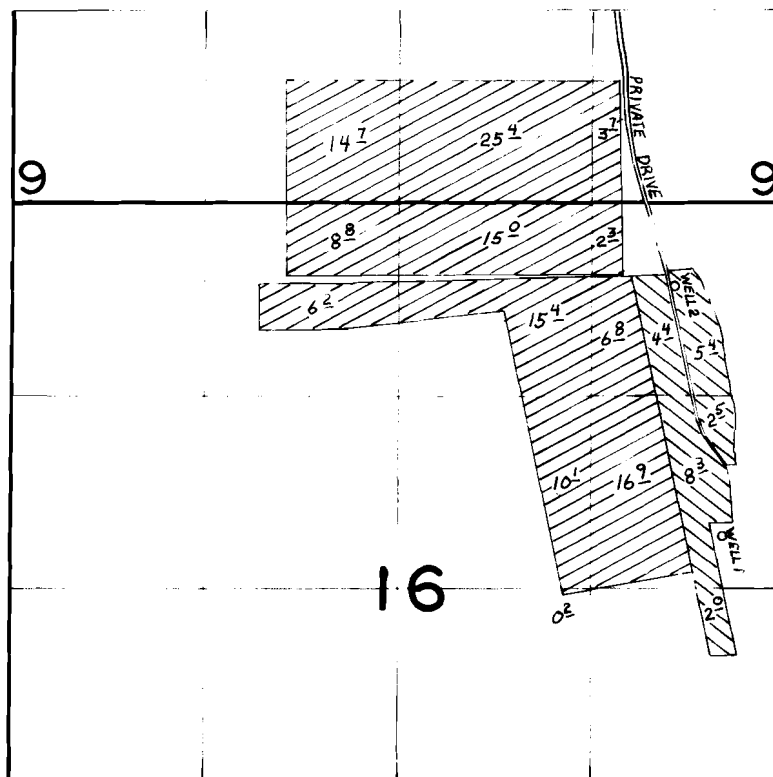

SCALE: 1"=1320'



WELL 1 LOCATED 2300'S. AND 420'W. FROM NE. COR. SEC. 16

WELL 2 LOCATED 580'S. AND 750'W. FROM NE. COR. SEC. 16

## FINAL PROOF SURVEY UNDER

Application No. G-5422 Permit No. G-5351  
IN NAME OF

L. E. KASEBERG

Surveyed MAY 9, 1985, by V. L. CHURCH