


T. 2S., R. 16E., W. M.

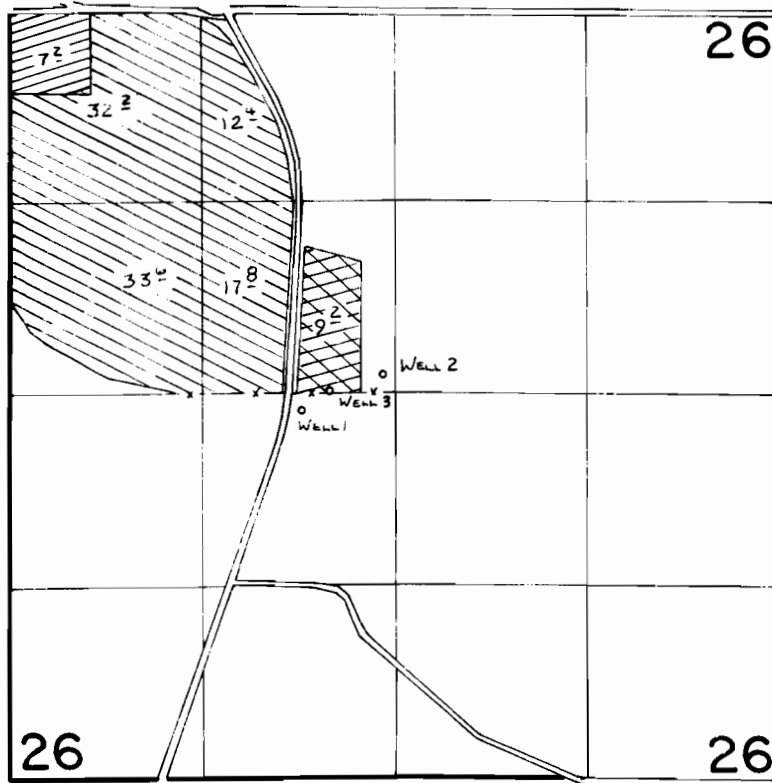

WELL 1 LOCATED 110'S. & 640' W. FROM
 WELL 3 LOCATED 10' N. & 450' W. FROM
 WELL 2 LOCATED 110' N. & 80' W. FROM } CENTER COR. SEC. 26




SCALE: 1" = 1320'

FINAL PROOF SURVEY UNDER

Application No. **G-8073** Permit No. **G-7608**
G-9324 **G-8759**
 IN NAME OF

WILLARD ROLFE

Surveyed **5-7-1985**, by **V.L. Church**

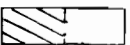WELL 1 & 2 PER. G-7608 
 WELL 3 PER. G-8759 
 WELL 2 PER. G-7608 