


G-5451  
76162  
54082

T. 4N. R. 29E. W.M.

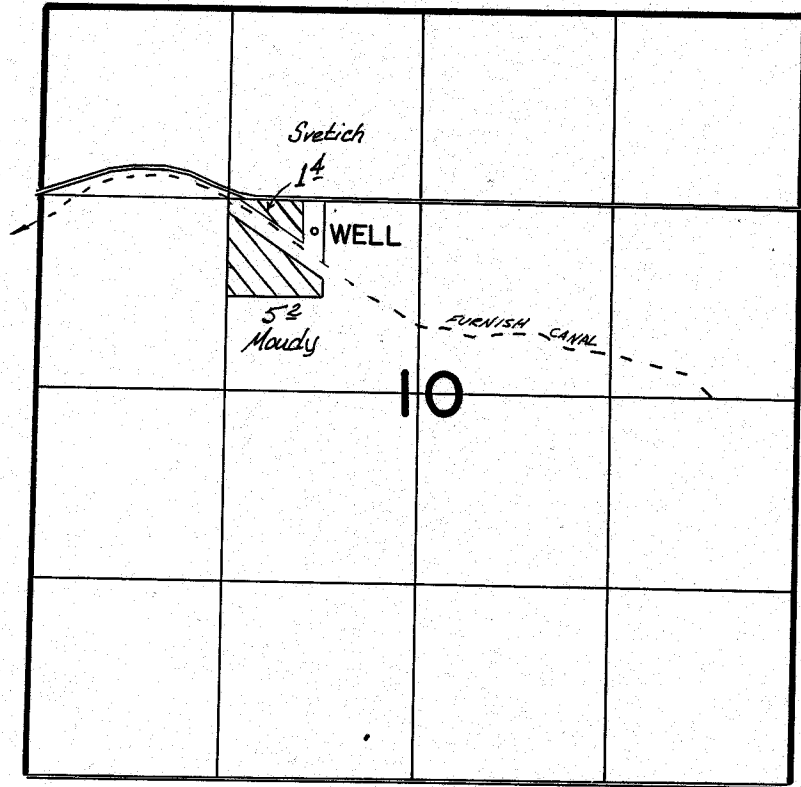

WELL LOCATED 1100'N & 720'W FROM CENTER SEC 10

**FINAL PROOF SURVEY**  
UNDER

Application No. G-5605... Permit No. G-5451.....  
IN NAME OF

STEPHEN MOUDY & RANDY L. & DOROTHY E. SVETICH

Surveyed 2-16..... 1979., by R. BARWIN.....