


G-6555  
54084

T. 4N., R. 29E., W.M.

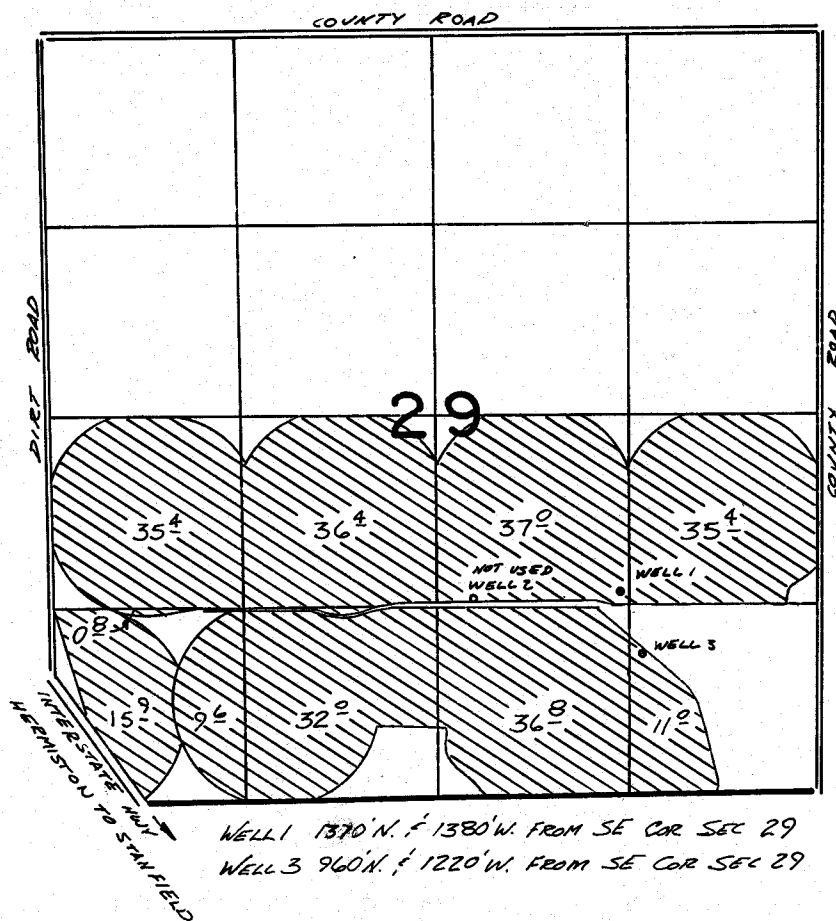

### FINAL PROOF SURVEY UNDER

Application No. G-7086 Permit No. G-6555  
IN NAME OF

MAURICE L. KOESTER

Surveyed Feb. 2 1972, by R. F. BARWIN  
Oct. 21 81 V. L. CHURCH  
Oct. 8 84 V. R. CHURCH

222L  
FL 6-18

v. l. c.