


G-6932

34023

T. 3N., R. 30E., W.M.



SCALE: 1" = 1320'

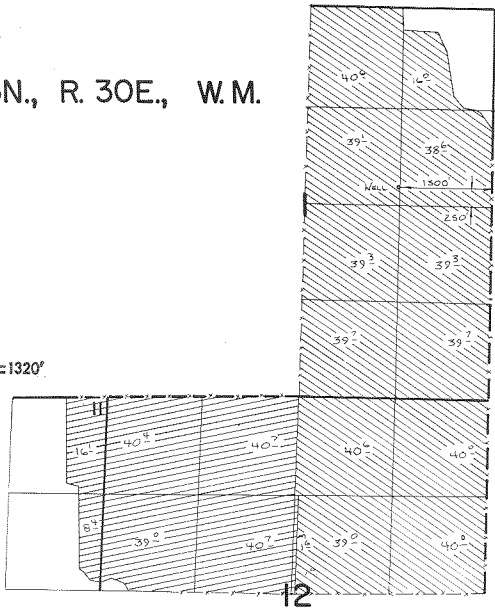

**FINAL PROOF SURVEY**  
 UNDER

G-7435

G-6932

Application No. G-10210 Permit No. G-9285

IN NAME OF

...THOMAS E. BRANSTETTER...

Surveyed Nov. 18. 1981, by H. H. Church

Nov. 5 81

