


G-9108
54087

T. 4N., R. 35E., W.M.

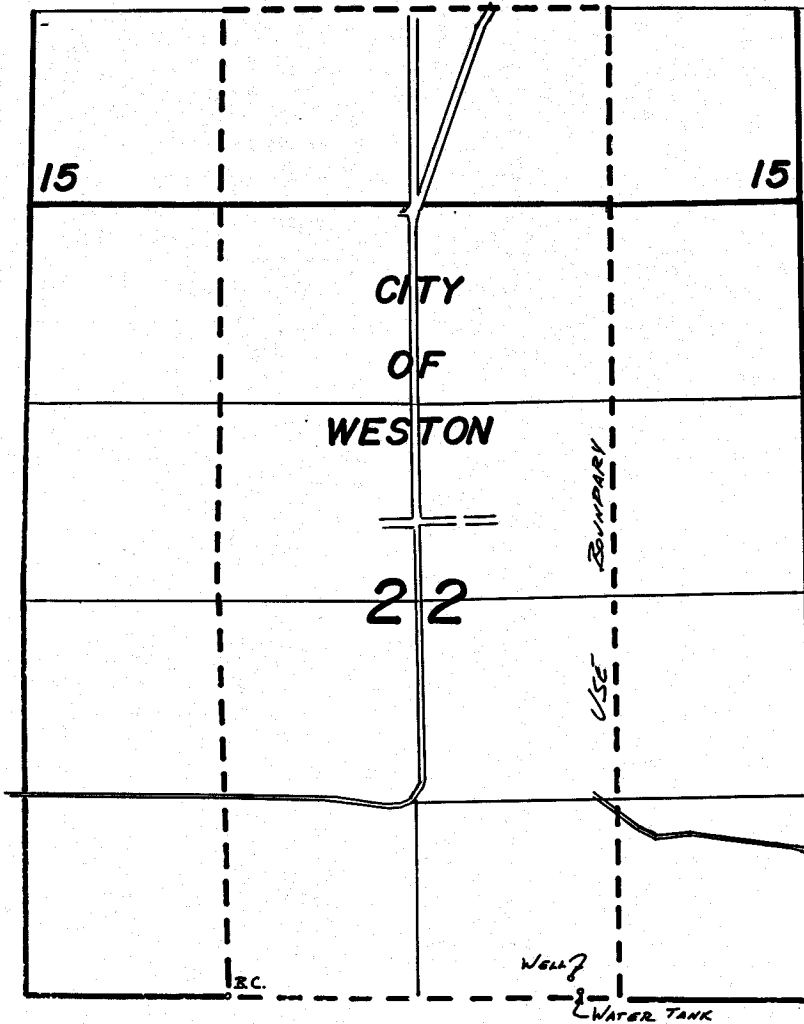

Well loc: 130' N. & 1670' W. FROM SE COR. SEC 22

FINAL PROOF SURVEY
UNDER

Application No. G-9972 Permit No. G-9108
IN NAME OF

CITY OF WESTON

Surveyed JUNE 28 1982, by V.L. Church

2092