


G-9344

54090

T. 6N., R. 35E., W.M.

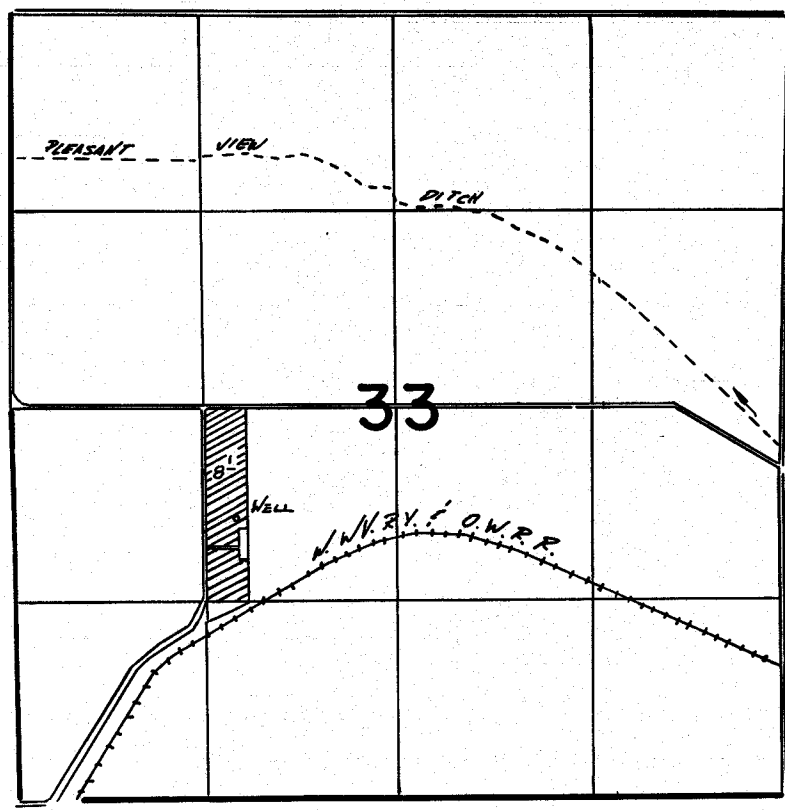

WELL LOC: 760'S & 1100'W. FROM CENTER SEC 33

FINAL PROOF SURVEY
UNDER

Application No. **G:9939** Permit No. **G:9344**
IN NAME OF

.....**MYRTLE JEAN TUCKER**.....

Surveyed *April 5*..... 1982., by *V.L. Church*.....