


G-9454
S4092

T. 2N., R. 32E., W. M.

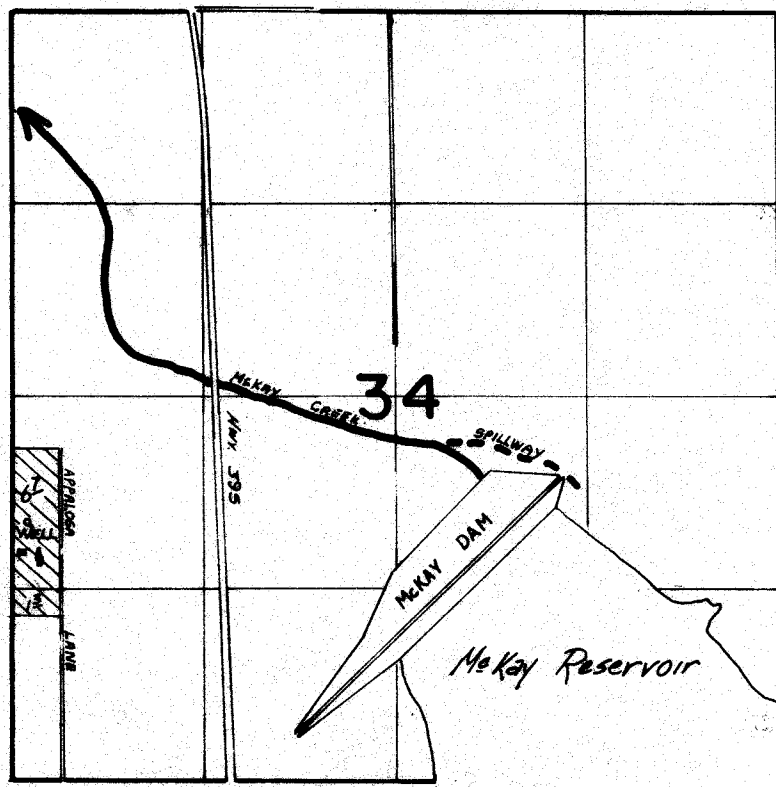

WELL LOCATED 1750' N. AND 130' E. FROM SW. COR. SECTION 34

FINAL PROOF SURVEY
UNDER

SCALE 1" = 1320'

Application No. G:10368 Permit No. G:9454...
IN NAME OF

LAWRENCE E. & GLADYS W. TREADWAY

Surveyed 4-24-1984, by K.L. Church.....

REVISED 2-7-85 JS
FIELD CREST ADDM. PLAT
74L K.L.C.