


T.3S. R.40E., W.M.

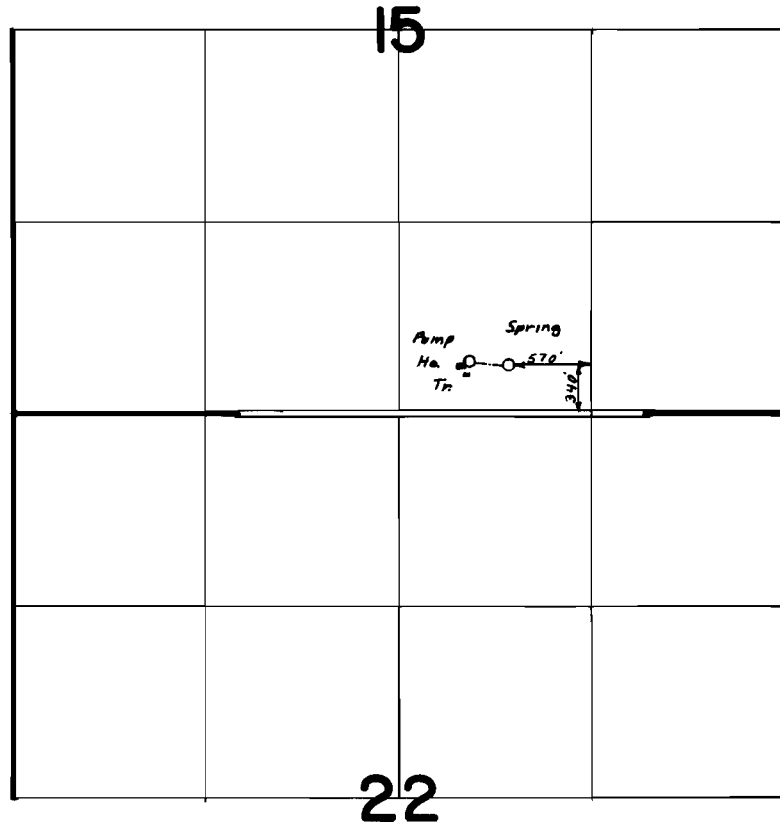

FINAL PROOF SURVEY
UNDER

Application No. 49126..... Permit No. 36837.....
IN NAME OF

.....DEAN L. & NANCY A. CORBIN..

Surveyed AUG. 28. 1979., by CHURCH-JARRETT