
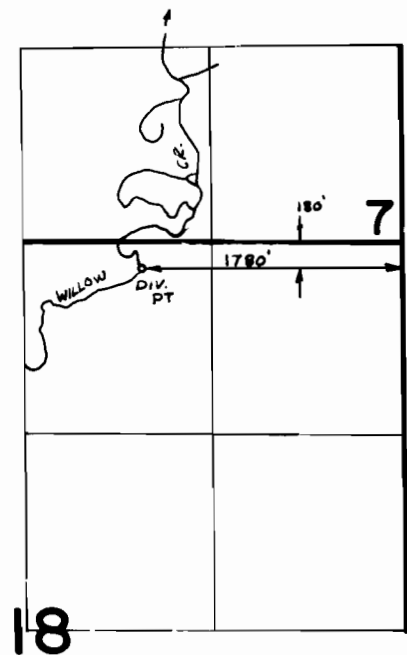


T. 1S. R. 39E. W. M.

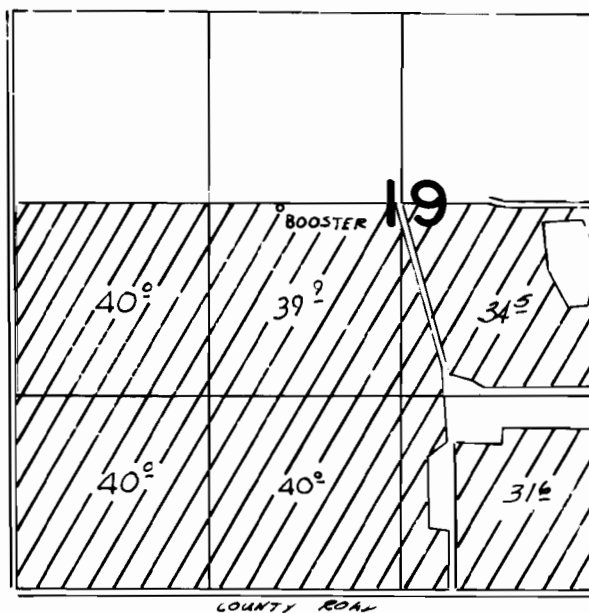

FINAL PROOF SURVEY
UNDER

Application No. 50101 Permit No. 37645
IN NAME OF

WILLIAM E. & FLORENCE HOWELL

Surveyed 8-27 1979, by V. Church