


T. 1S., R. 40E., W.M.

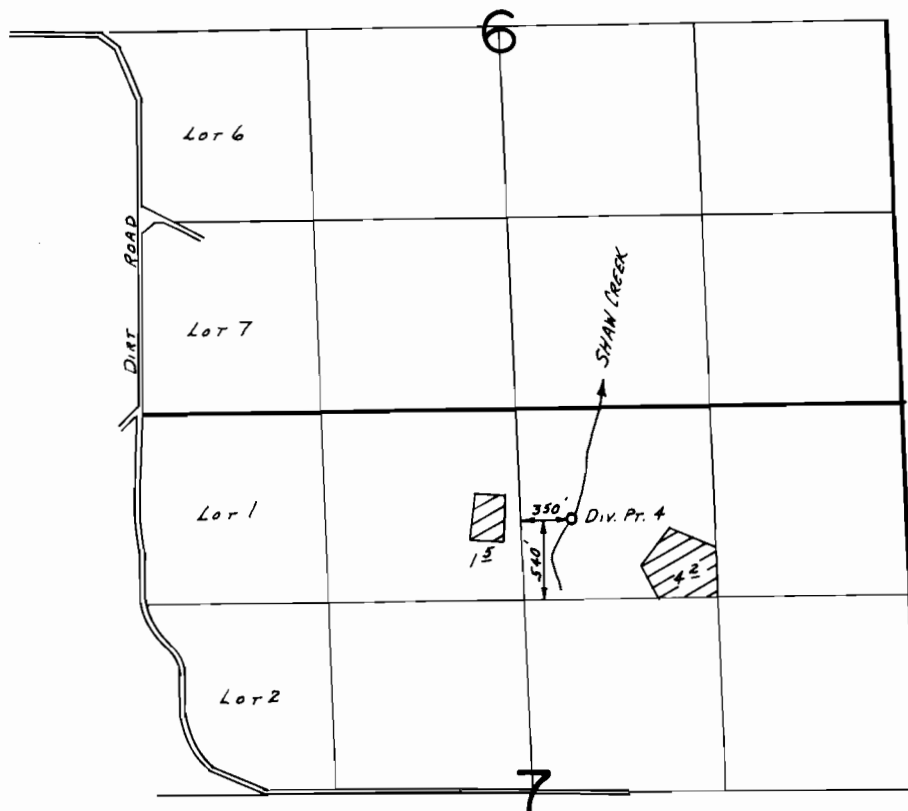

SCALE: 1" = 1320'

FINAL PROOF SURVEY UNDER

Application No. 50611... Permit No. 38246.....
IN NAME OF

DONALD A. & MARY C. CALDER.

Surveyed Aug. 28, 1979, by V. CHURCH & D. JARRETT