


T. 3S. R. 40E. W. M.

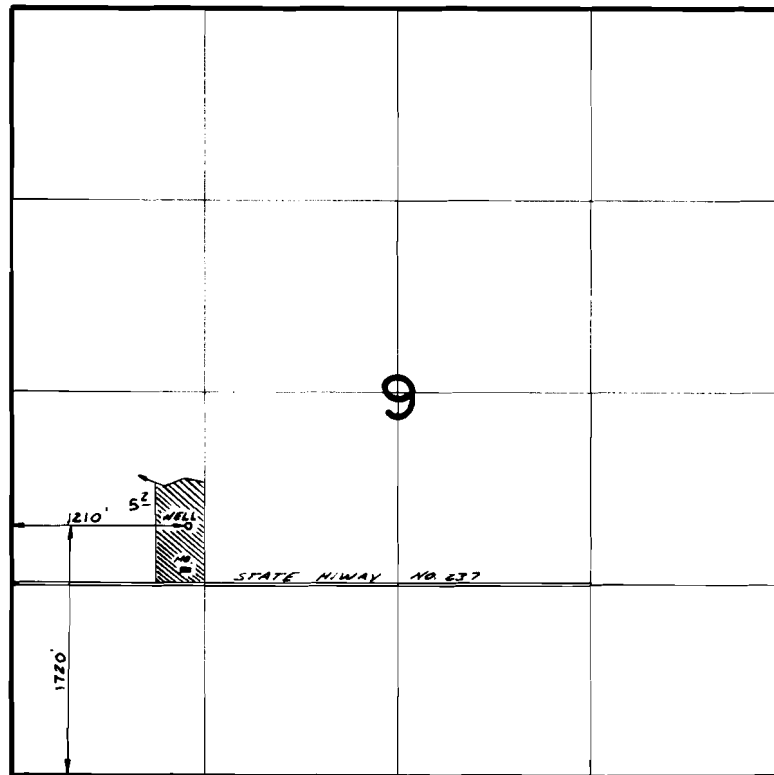

FINAL PROOF SURVEY
UNDER

Application No. G-5574 Permit No. G-5437
IN NAME OF

MARVLYN RUDD

Surveyed 8-28 1977, by W. Church & P. Sarrett