



# T. 1N. & IS. R. 43E. W. M.

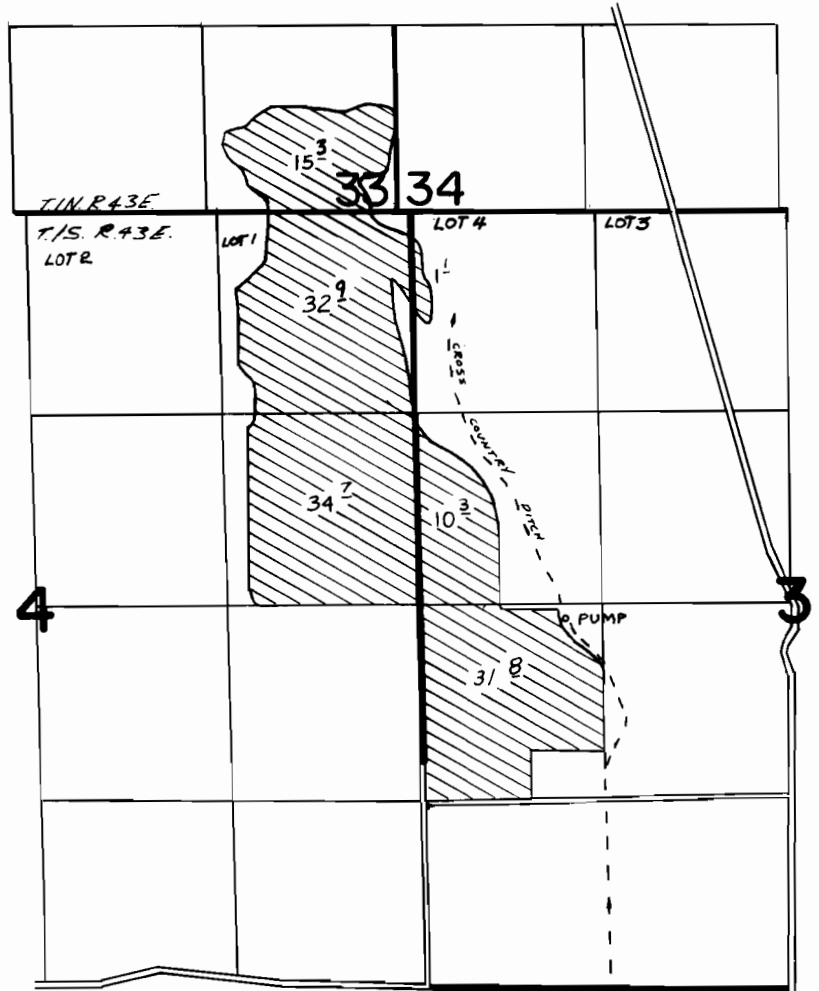

SCALE: 1"=1320'

## SEC 11

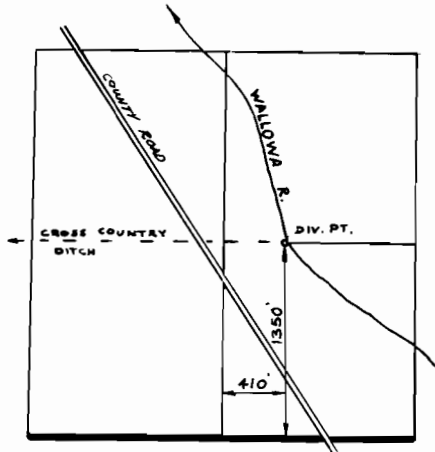

## FINAL PROOF SURVEY UNDER

Application No. 45938..... Permit No. 34108.....  
IN NAME OF

.....EDITH HAUN CLARK.....

Surveyed 8-28..... 1978., by R. BARWIN.....