

Sec 2 T7S R1E W.M.


STATE ENGINEER
RECEIVED

JAN 22 1923

SALEM, OREGON

2

Application No. 8793
Permit No. 5762

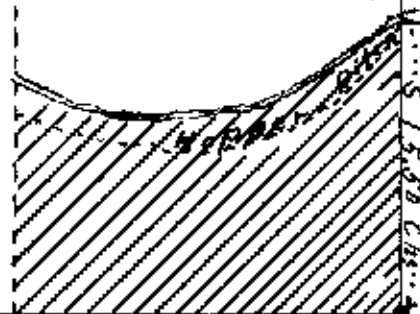

S.E. cor. Sec. 2
T7S. R. 1E.

I Nathan C. Hubbs of Silverton Ore do hereby certify that this map was made from notes taken during an actual survey made by me on Nov 27 1922 and that it correctly represents the works described in the accompanying application, together with the location of stream and ditch.

Nathan C. Hubbs,
Registered Professional Engineer

Oreg No. 913.