


SW⁴, Sec. 15
T1N, R48E, W.1M.

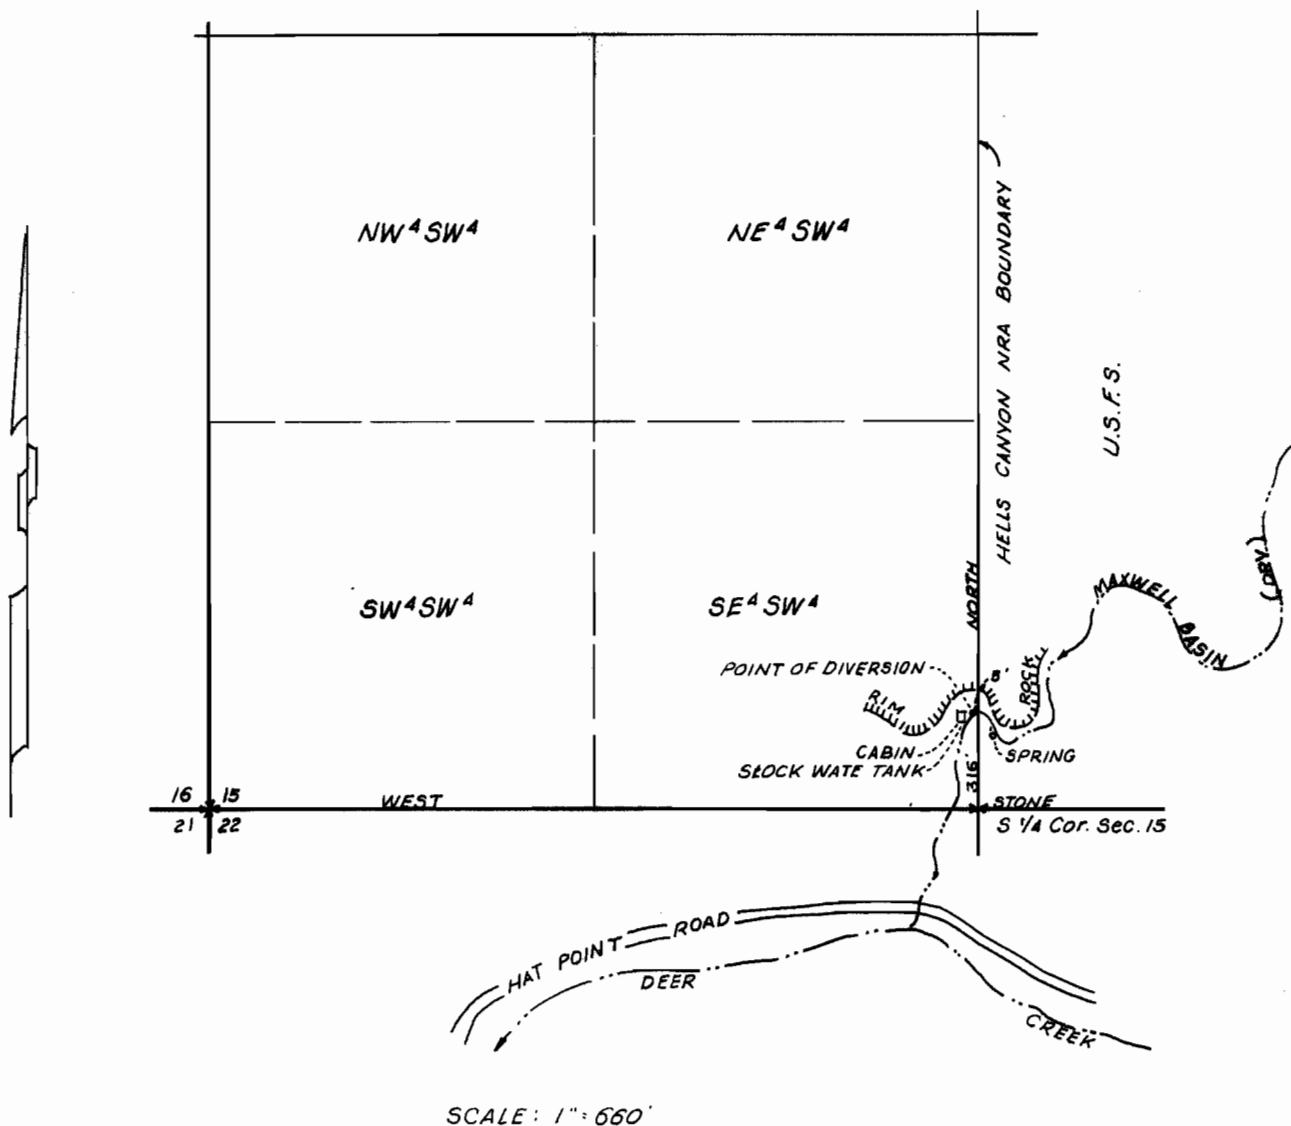

Prepared for Hazel Johnson

By: Verne H. Russell - Ore. PLS No 427 Date: Nov. 18, 1977

Note: Point of diversion is located within the SE 1/4 SW 1/4 and bears North 316 feet and West 5 feet from the South 1/4 cor. Sec 15, T1N, R48E, W.1M. Spring is located on U.S.F.S. land runs in defined channel of Maxwell Basin and disappears under ground near the point of diversion

Water to be diverted thru 60 feet of 1 inch G.I.P. to cabin site and stock water tank.

Application No. 56907
Permit No. 42787

