


T. 1 N. R. 42 E., W. M.

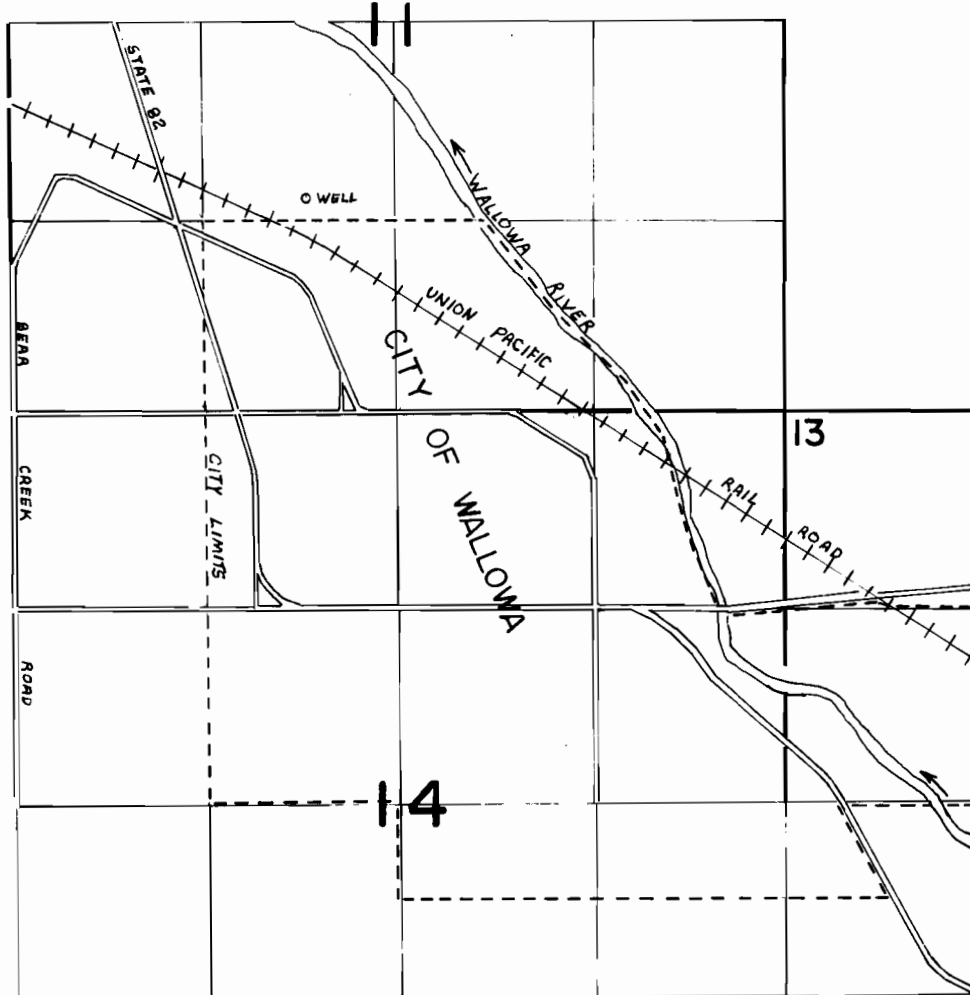

SCALE: 1"=1320'



WELL LOCATED 150' N. AND 600' W. FROM NE. COR. OF SE 1/4, SW 1/4, SEC. 11

FINAL PROOF SURVEY

UNDER

Application No. G-3860 Permit No. G-3353.....

IN NAME OF

CITY OF WALLOWA

Surveyed Aug. 26..... 1985., by J.L. CHURCH.....