


T.2N. R.13E. W.M.

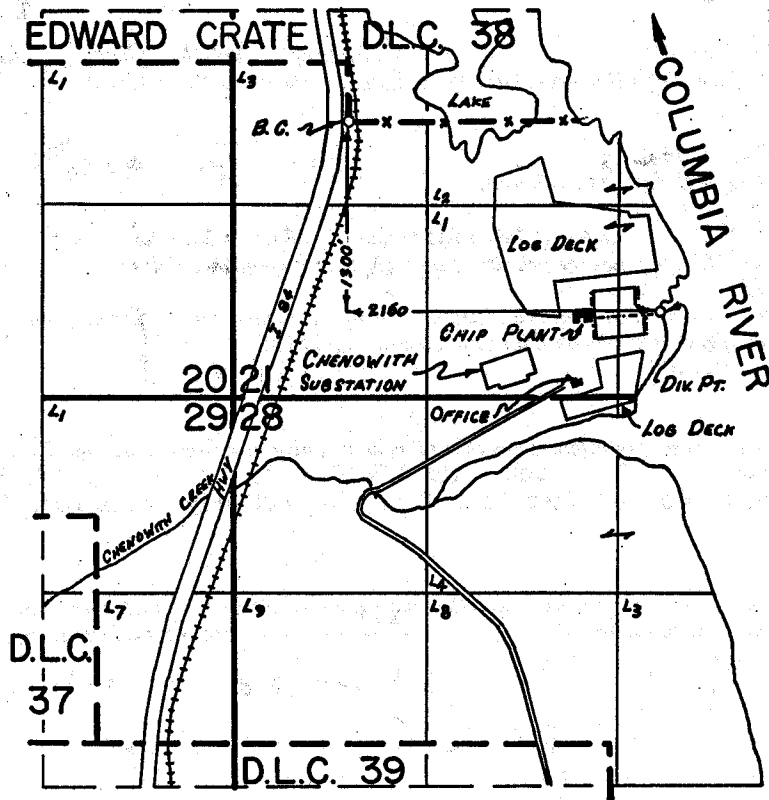

FINAL PROOF SURVEY
UNDER

Application No. 56644. Permit No. 43313...
IN NAME OF

MOUNTAIN...FIR...LUMBER...CO...INC.

Surveyed DEC..11.. 1981., by .T...PAUL.....