


SCALE : 1"=1320'

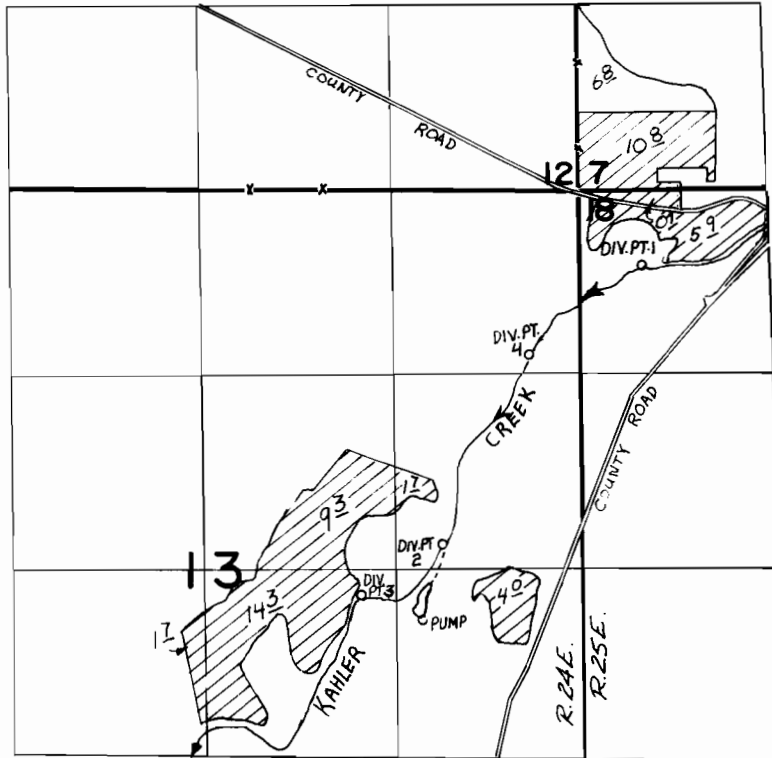

DIV. PT. 1 LOCATED 500' S. AND 430' E. FROM NW. SEC. COR. SEC. 18
DIV. PT. 2 LOCATED 2420' S. AND 960' W. FROM NE. SEC. COR. SEC. 13
DIV. PT. 3 LOCATED 2770' S. AND 1520' W. FROM NE. SEC. COR. SEC. 13
DIV. PT. 4 LOCATED 1120' S. AND 360' W. FROM NE. SEC. COR. SEC. 13

Tr. O-44

Application No. 54405, Permit No. 40769.....
IN NAME OF

ROBERT M. & ELEANOR M. ORDWAY

Surveyed AUG.14..... 1979.., by S. BROWN.....