


T.1 & 2 N. R.21 & 22 E. W.M.

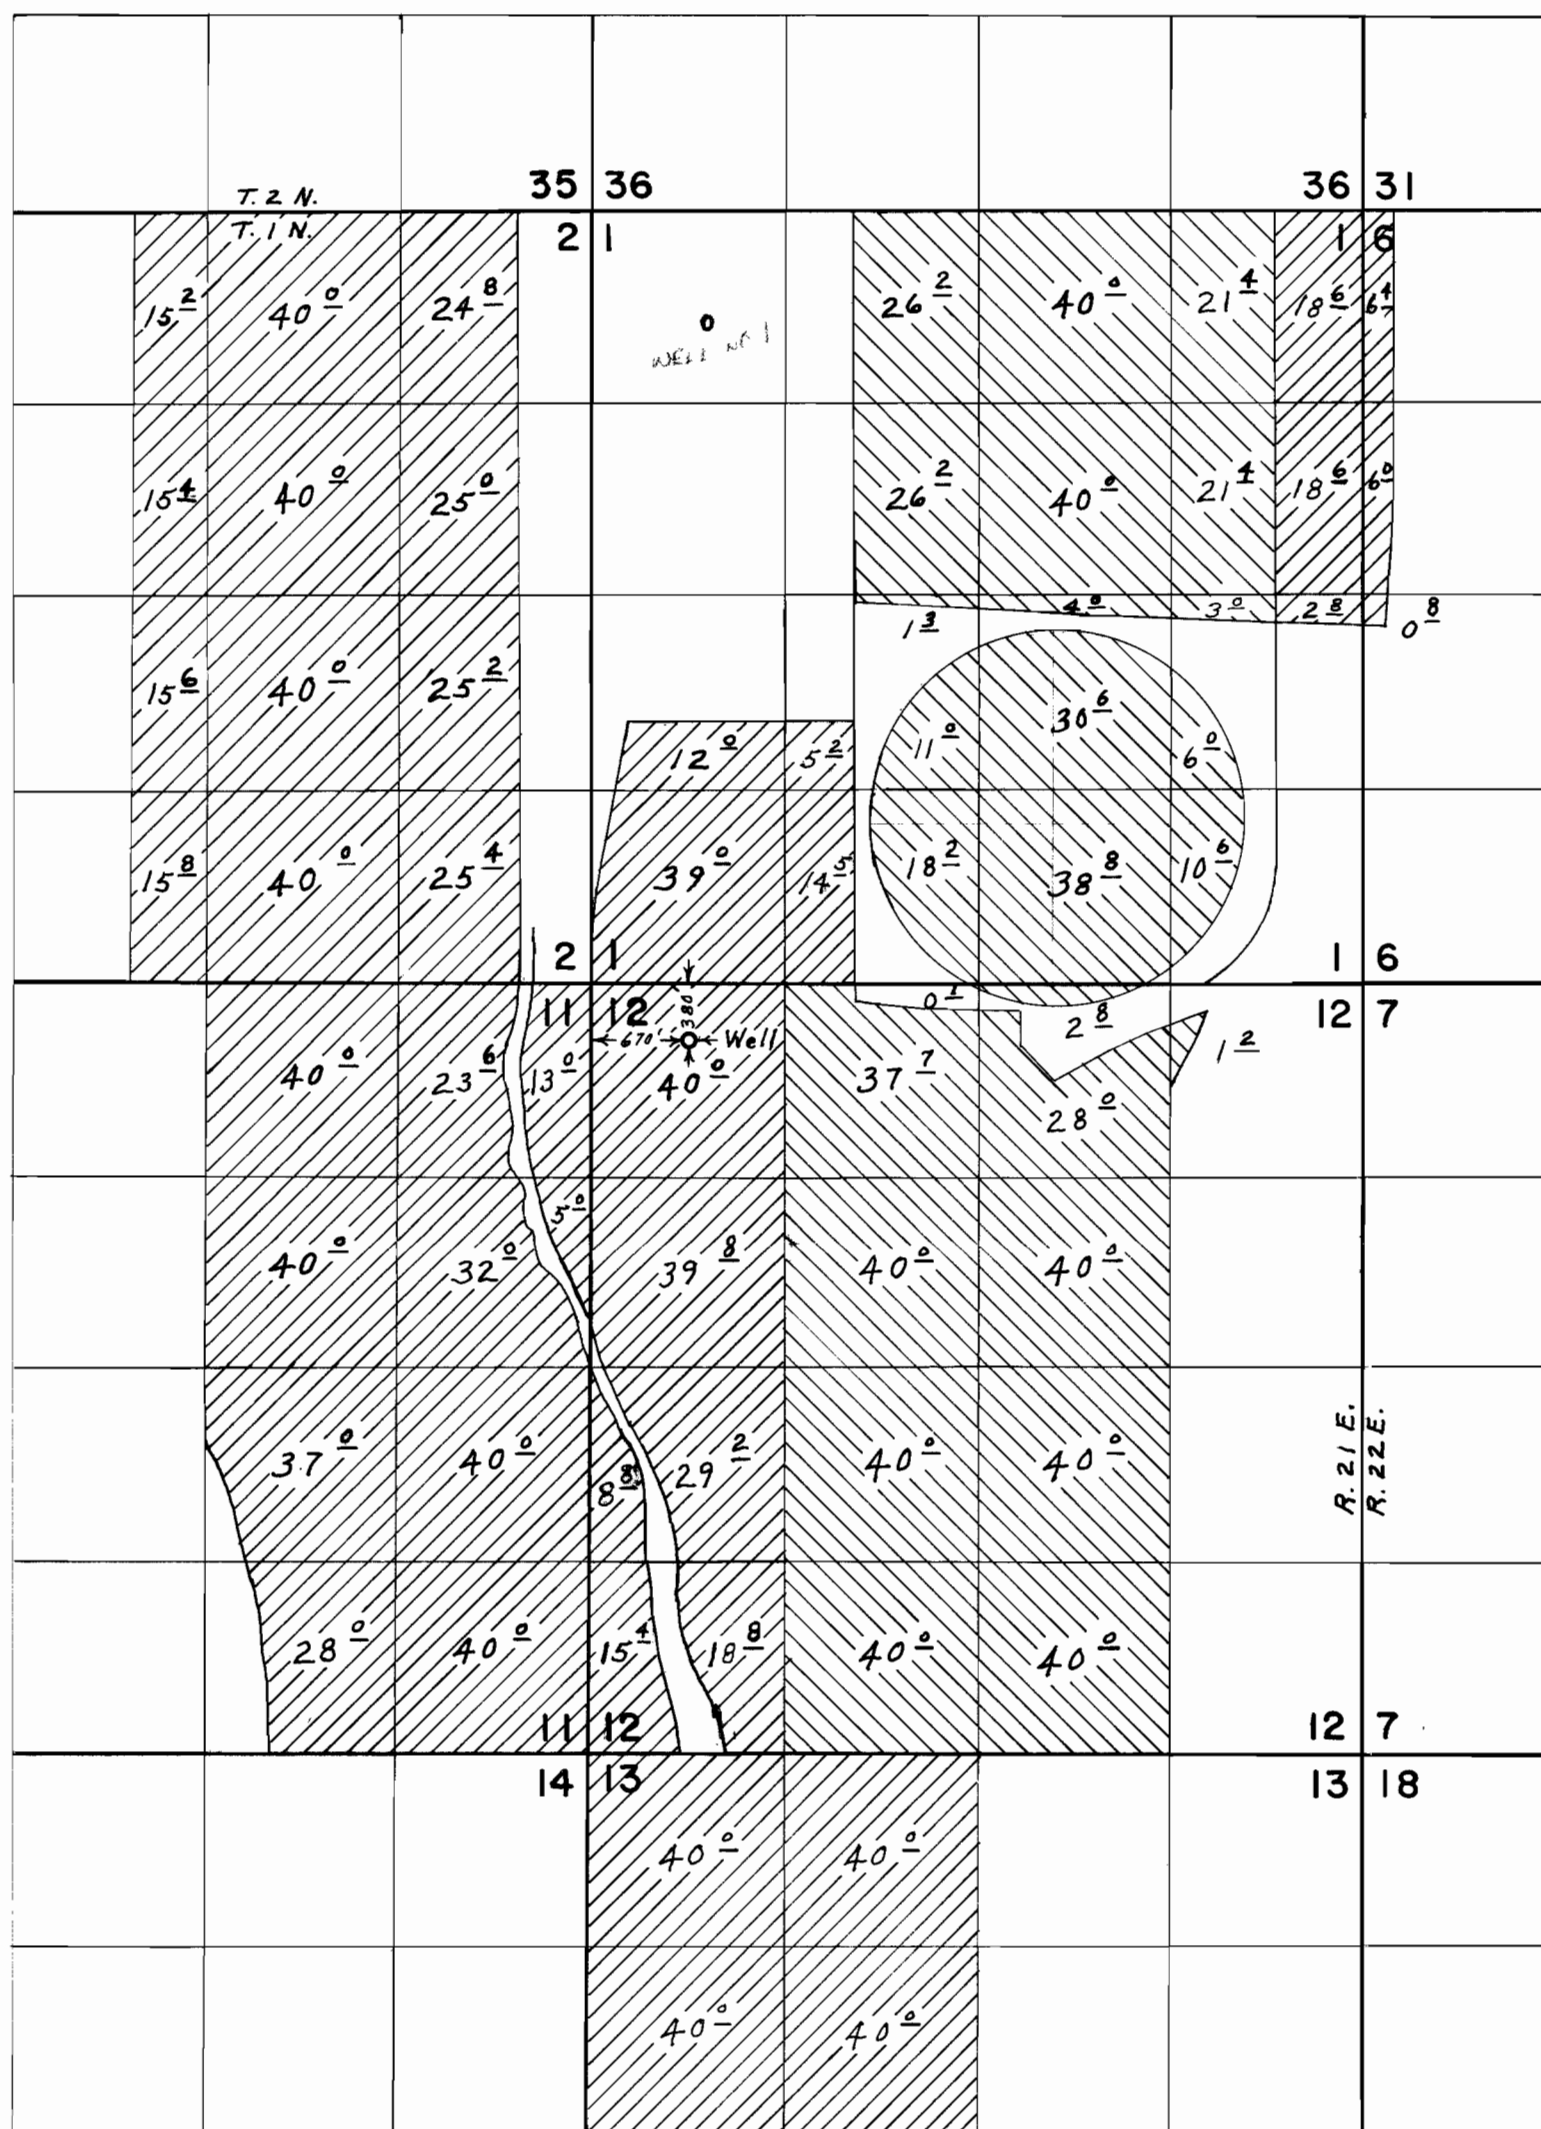

FINAL PROOF SURVEY

UNDER

Application G-4405 G-5027 and G-4302 G-4741

NAME OF
PLATEAU FARMS

April 5, 1974 by L. E. Gould