


T.10 S., R. 1 W. W.M.

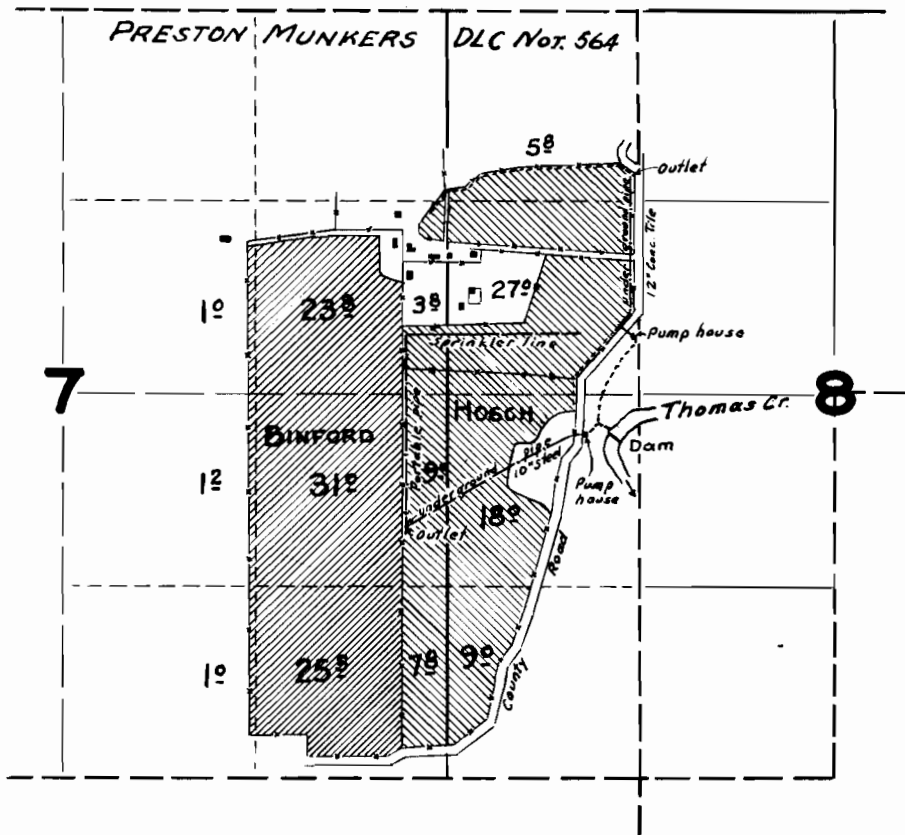

FINAL PROOF SURVEY UNDER

Application No. 16542 Permit No. 12547

IN FAVOR OF

Winnie A. Hasch and Sylvia J. Binford

Surveyed Sept. 16, 1942, by Geol. Mademan