


T. 586N., R. 35 & 36E., W.M.

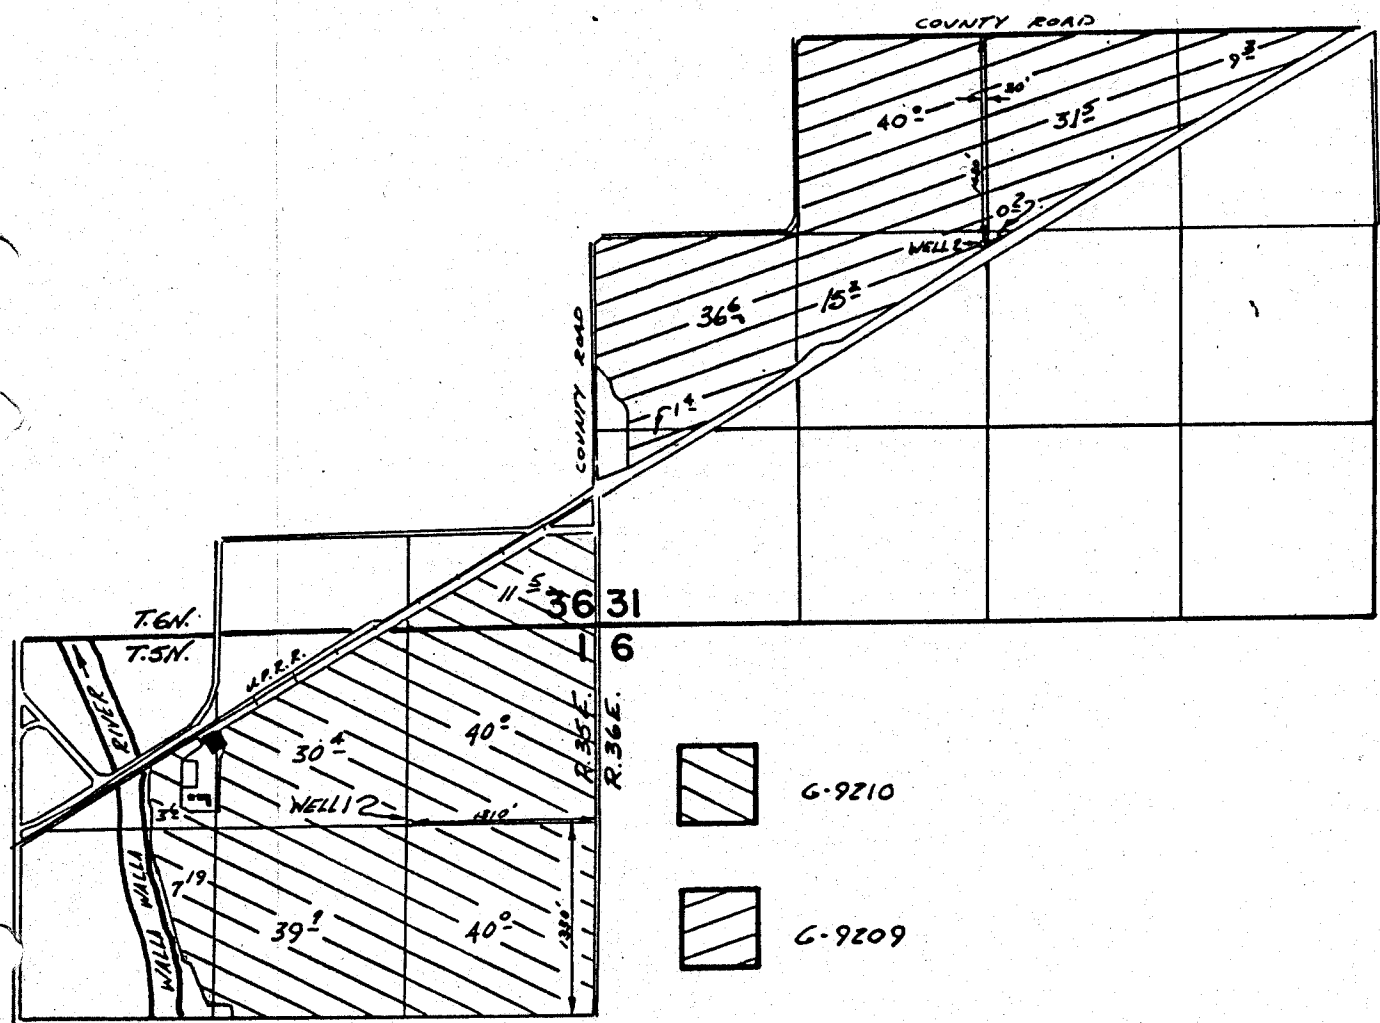

**FINAL PROOF SURVEY**

UNDER

TRANSFER 4412

G-9580                      G-9209

Application No. G-9581    Permit No. G-9210

IN NAME OF

.....MILTON NURSERY CO., INC.....

Surveyed 4-8-1982, by *Edmond B. Church*