


•

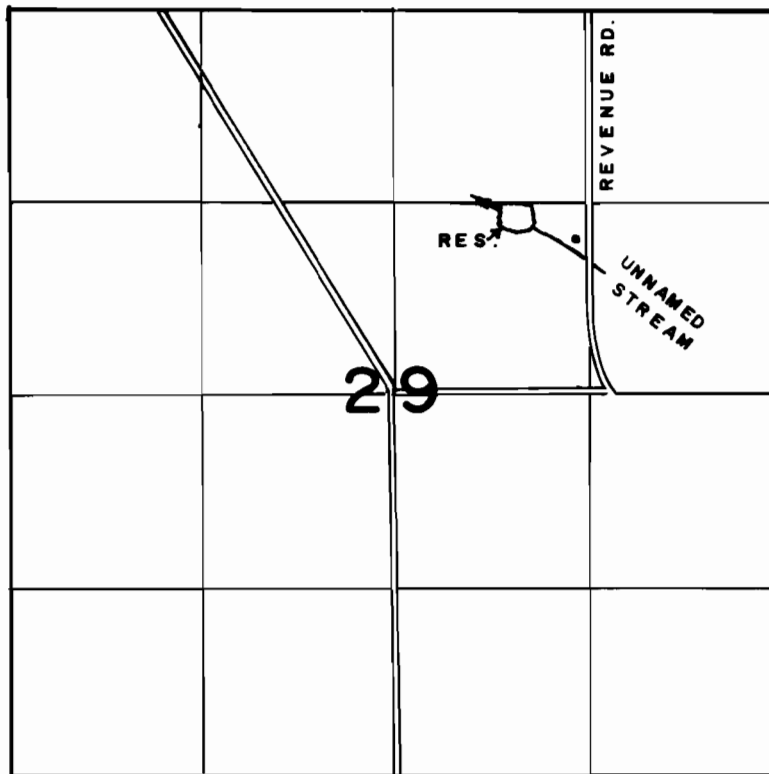

# FINAL PROOF SURVEY

## UNDER

Application No. R-57824 Permit No. R-7.7.7.8  
IN NAME OF \_\_\_\_\_

.....E. E. BECKER.....

Surveyed MAY 10, 1979, by R. G. MUCKEN