


T.2S.R.5E.W.M.

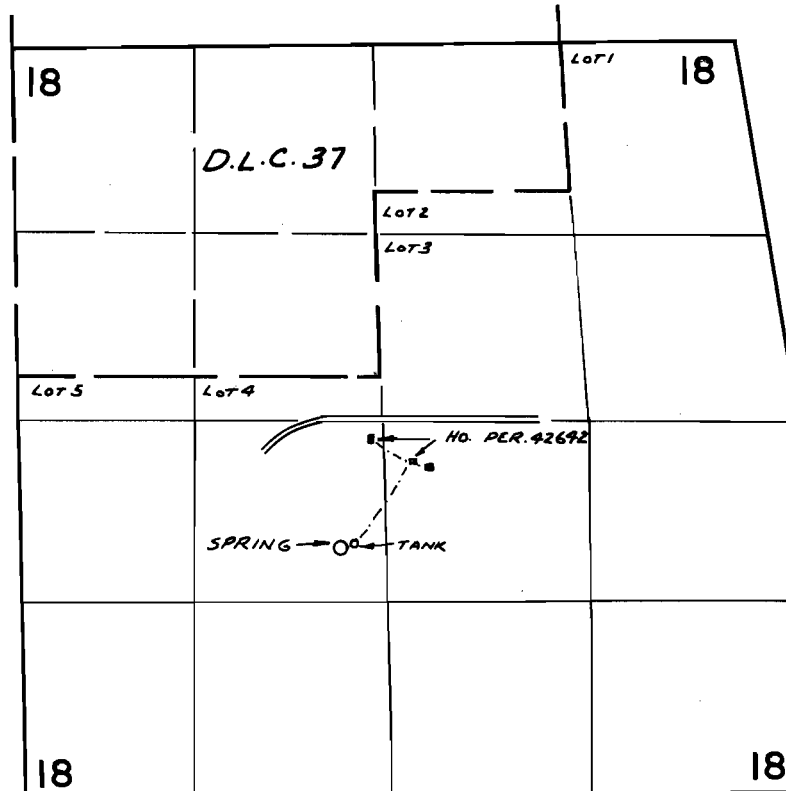

SPRING LOC: 880'S. & 300' W. FROM CEN. SEC. 18

FINAL PROOF SURVEY
UNDER

Application No. 48196 Permit No. 42642
IN NAME OF

DONALD C. LOWE & HERMAN F. MEYER

Surveyed AUG. 15, 1977, by R. MUCKEN
MAY 8, 1979