


T.2S.R.5E.W.M.

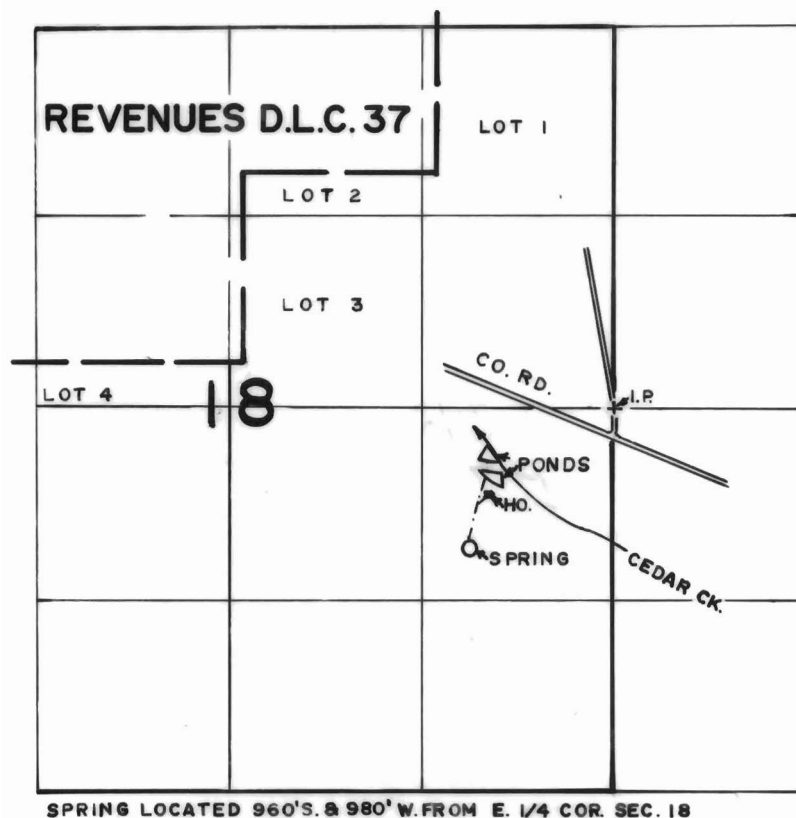

FINAL PROOF SURVEY UNDER

Application No. 58.335. Permit No. 43931.....
IN NAME OF

JOHN H. FRICK.....

Surveyed MAY. 8... 19.79, by R.G. MUCKEN...