


T.28S. R.12W. W.M.

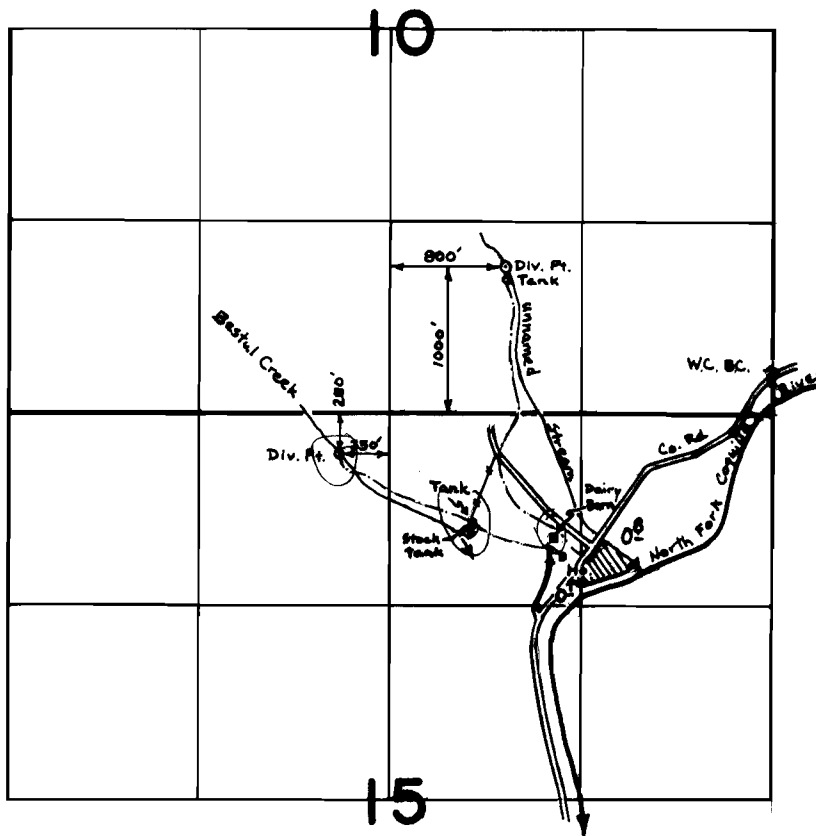

SCALE: 4" = 1 mile

FINAL PROOF SURVEY

UNDER

47568 35615

54462 40854

Application No. 56191... Permit No. 42297.....

IN NAME OF

CECIL A. and/or BLANCH WELZHEIMER

Surveyed July.22.. 1980, by S.Donaldson.....