


T.23S., R.12W., W.M.

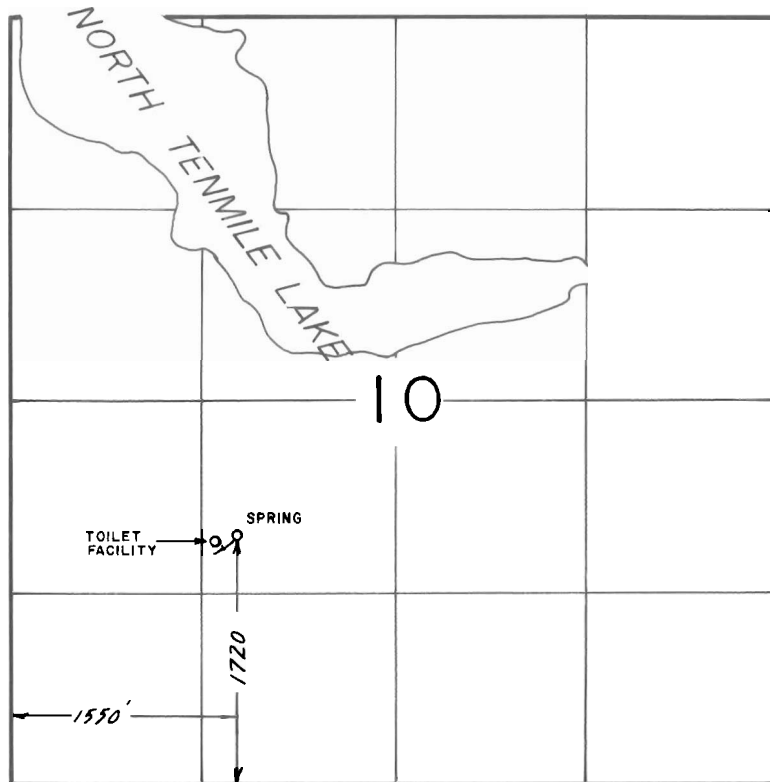

**FINAL PROOF SURVEY**  
UNDER

Application No. 49629.. Permit No. 37226.....  
IN NAME OF

JOHN R. & JOY KLOBAS & WILLY & NANCY L. BEPLAT

Surveyed JUNE 17.. 1980., by J.S. DONALDSON