


T. 27 S., R. 12 W., W.M.

SEC. 34

NE 1/4 NE 1/4

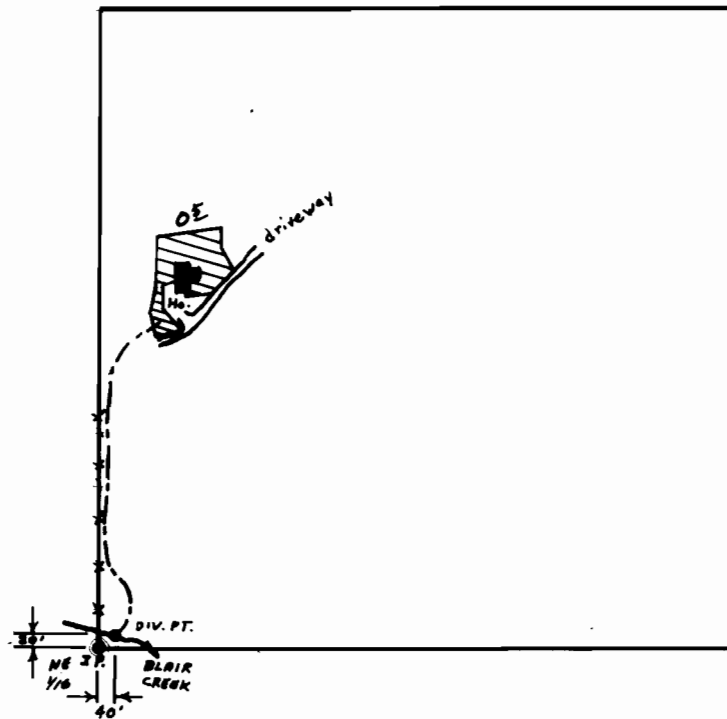

SCALE : 1" = 400'

FINAL PROOF SURVEY
UNDER

Application No. 52.768. Permit No. 39722.
IN NAME OF

EVELYN Y. BAXTER

Surveyed SEPT. 13, 1979, by S. DONALDSON