


T.22S. R.8W. W.M.

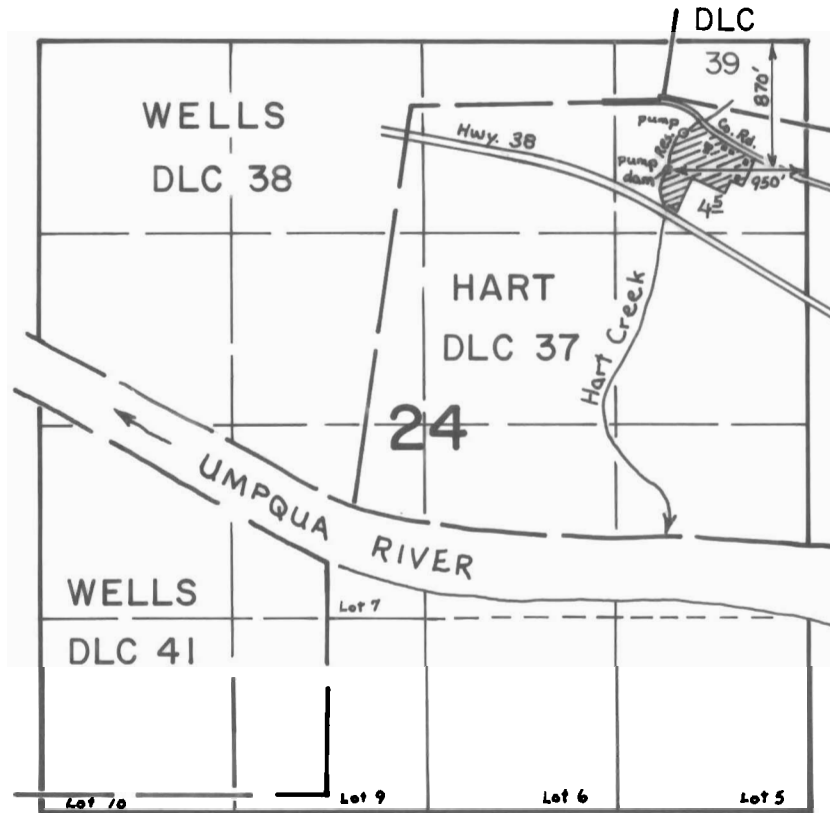

SCALE: 4" = 1 mile

**FINAL PROOF SURVEY**  
UNDER

R-49360                      R-6007  
Application No. 49630 Permit No. 37102  
IN NAME OF

JAMES W. & SYLVIA N. CRITES

Surveyed Sept. 4, 1979., by S. Donaldson.