


T. 27S., R. 7W., W.M.
 SEC. 32

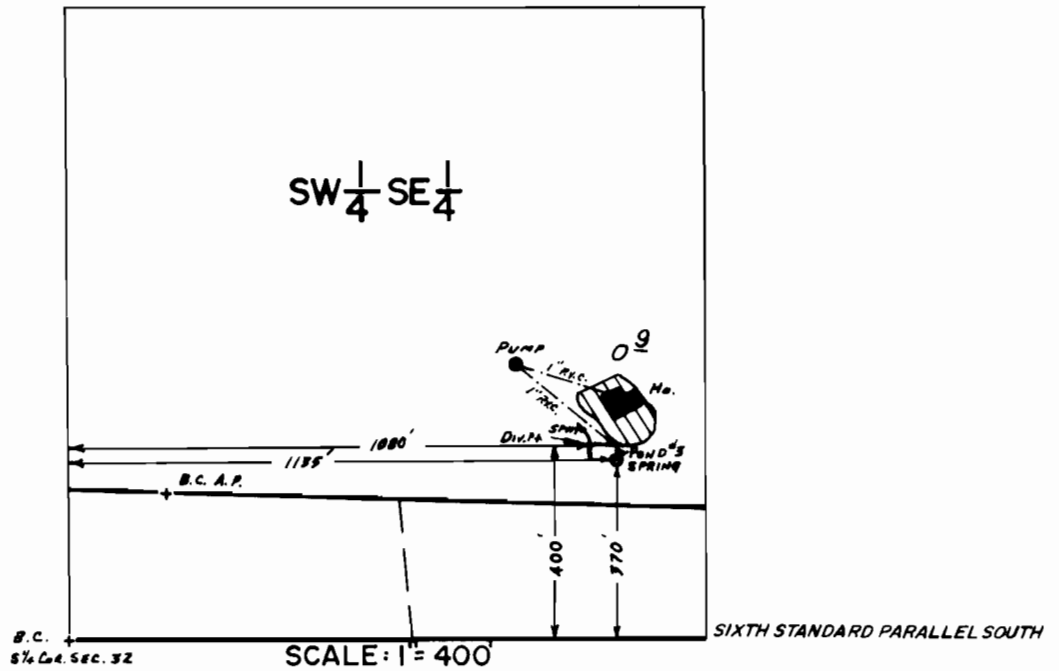

FINAL PROOF SURVEY
 UNDER

R-51907 R-6267
 Application No. 51908. Permit No. 39159.....
 IN NAME OF

JAMES GEORGE MAIN.....

Surveyed JUNE 20, 1979, by J.S. DONALDSON