


T. 27S., R. 7W., W.M.
SEC. 32

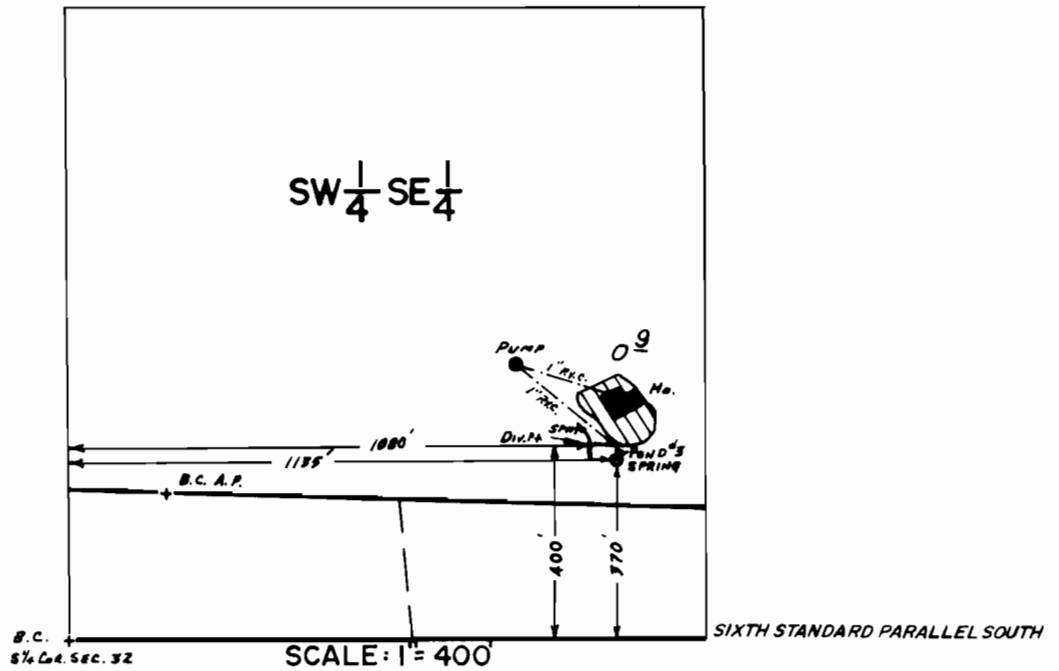

FINAL PROOF SURVEY
UNDER

R-51907 R-6267
Application No. 51908. Permit No. 39159.....
IN NAME OF

JAMES GEORGE MAIN.....

Surveyed JUNE 20, 1979, by J.S. DONALDSON