


T.30 1/2 31 S. R.6 W. W.M.

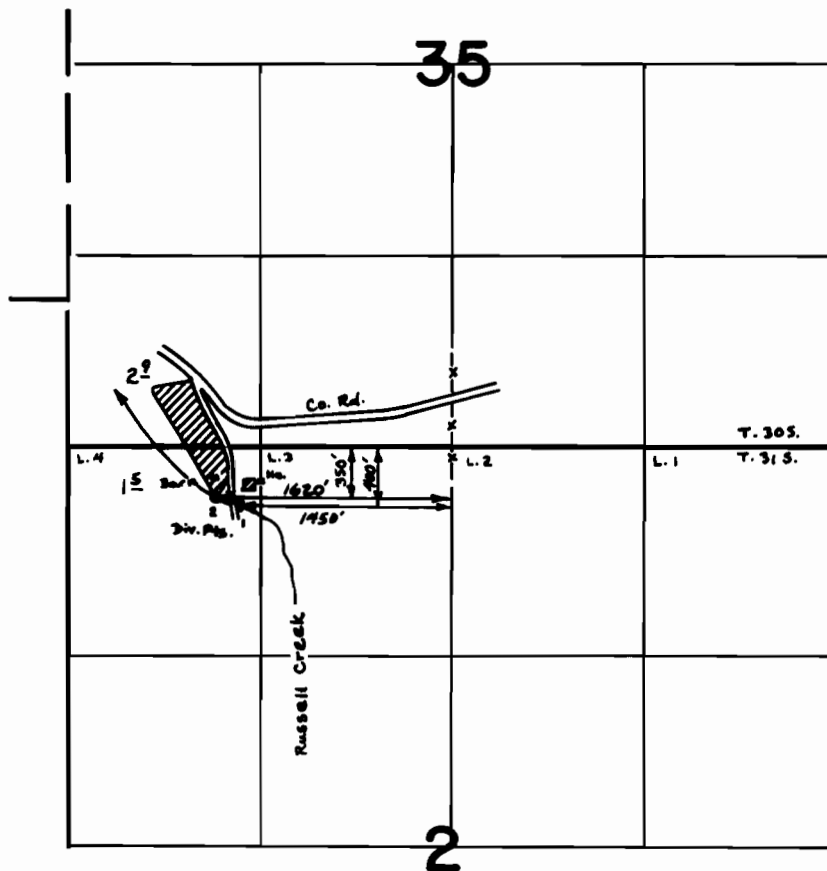

SCALE: 4" = 1 mile

FINAL PROOF SURVEY
UNDER

Application No. 48448 Permit No. 36367
IN NAME OF

LEE FENTER

Surveyed Nov. 1, 1979, by S. Donaldson