


T. 30S., R. 3W., W.M.

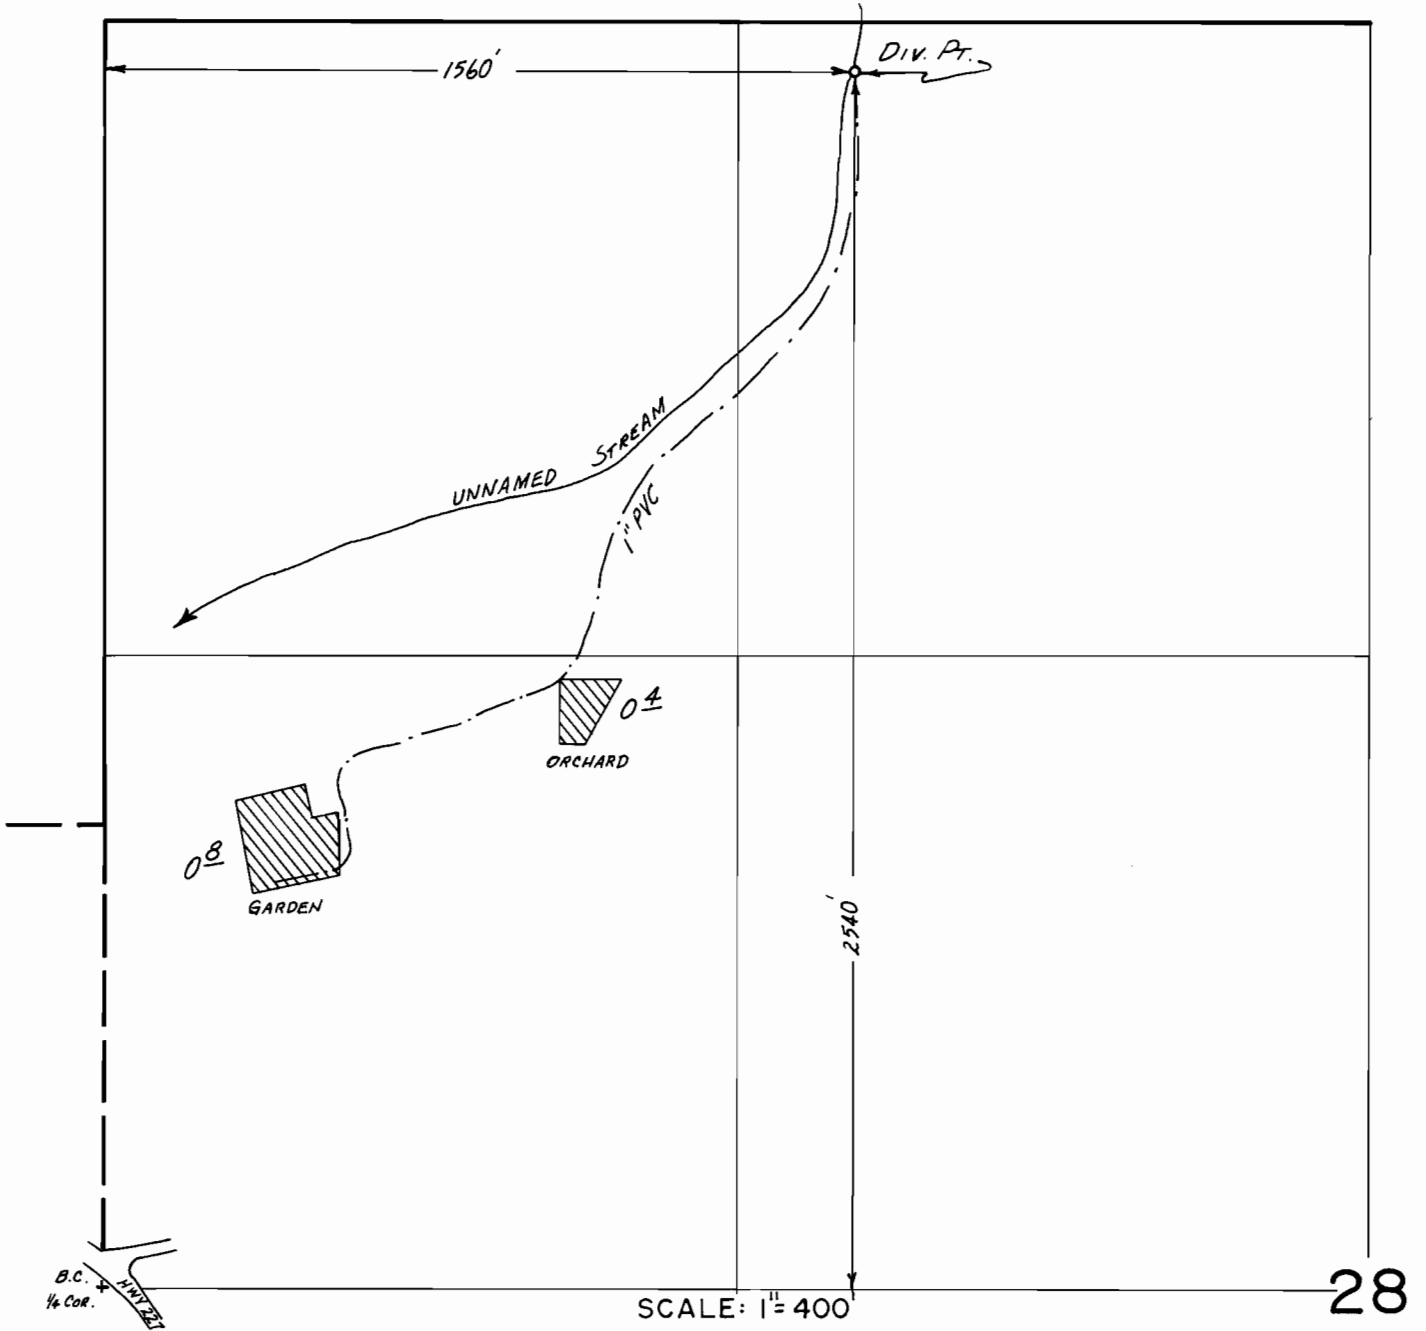

**FINAL PROOF SURVEY**  
UNDER

Application No. 49816... Permit No. 37291.....  
IN NAME OF

.....JAMES R. & CELIA M. ROAF.....

Surveyed Mar. 20.. 19.79., by J.S. DONALDSON