


T. 30S., R. 3W., W.M.

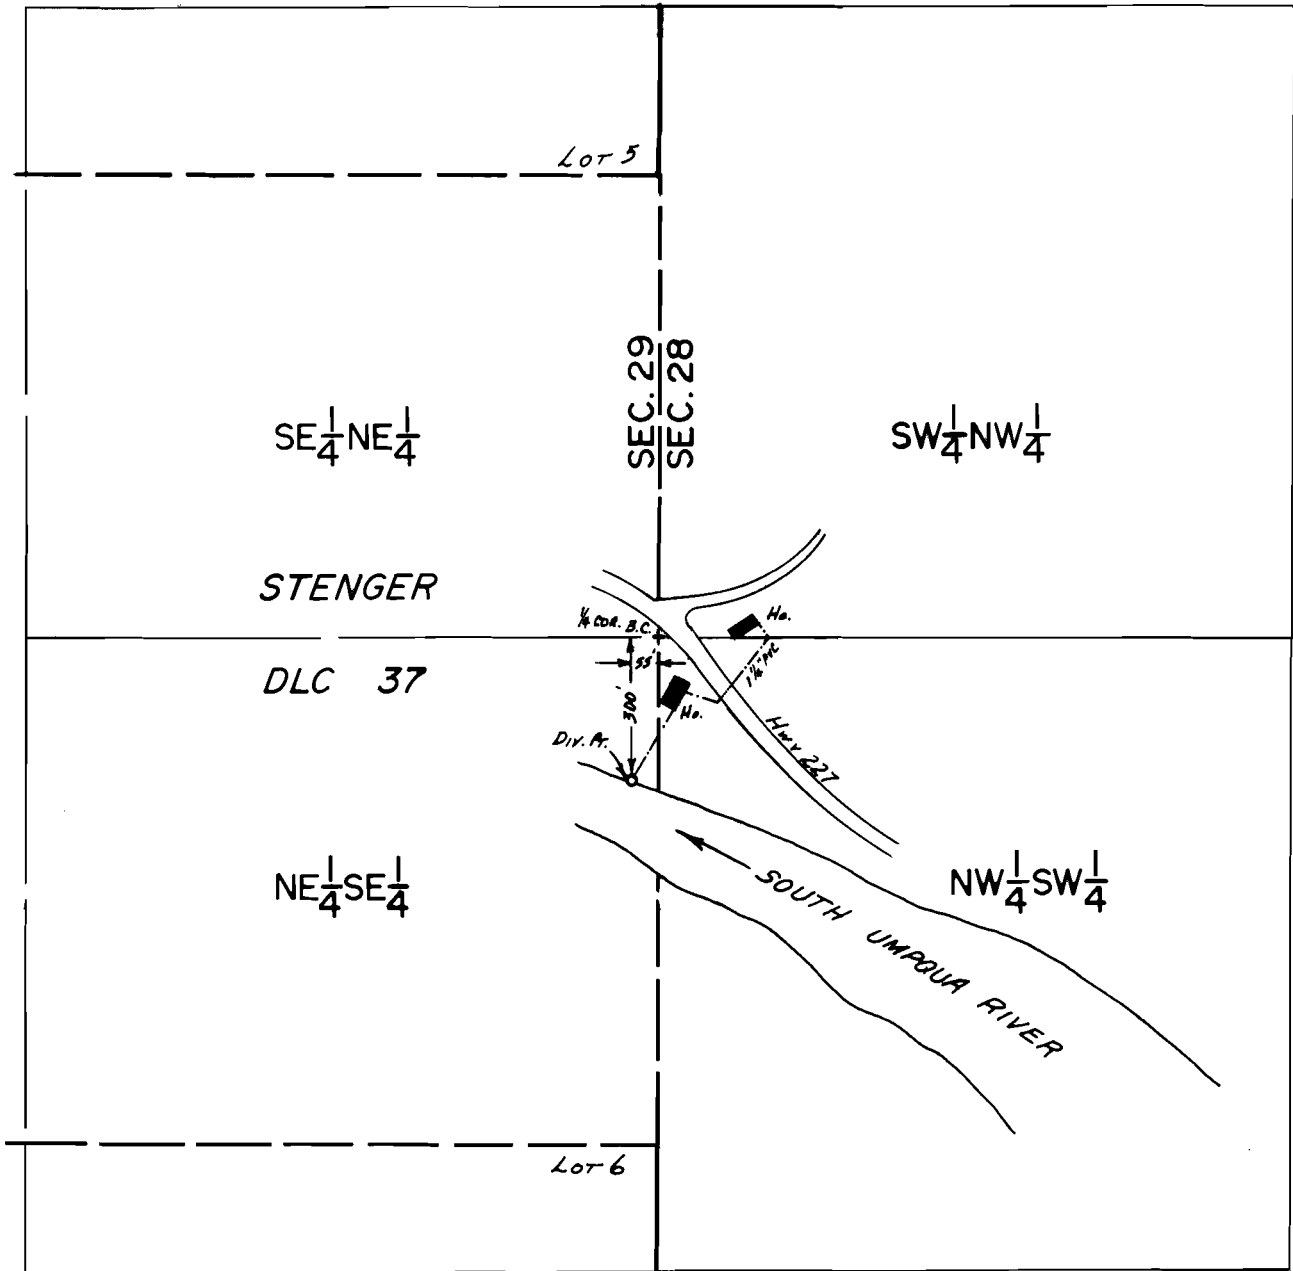

SCALE: 1"=400'

**FINAL PROOF SURVEY**  
UNDER

Application No. 56385.. Permit No. 42155.....  
IN NAME OF

..... JAMES R. & CELIA M. ROAF .....

Surveyed Mar..20.. 19.79, by J.S. DONALDSON