


T. 26 S. R. 5 W. W.M.

Sec. 7

SW 1/4 SW 1/4

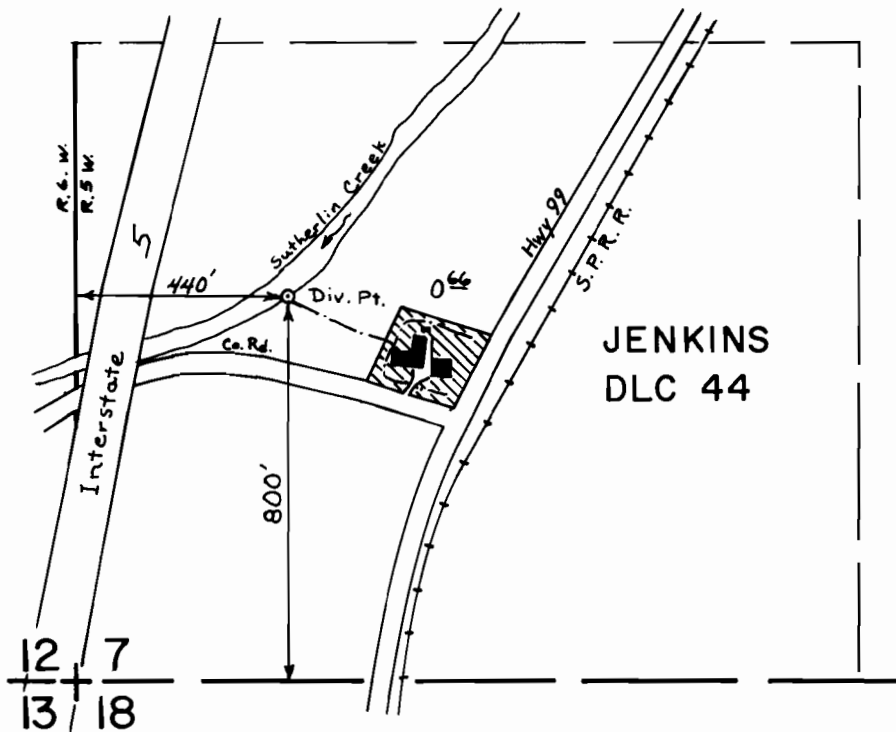

SCALE: 1" = 400'

FINAL PROOF SURVEY

UNDER

Application No. 50109 Permit No. 37650

IN NAME OF

AIMO KYTOLA

Surveyed April 30, 1979, by S. Donaldson