


T. 26S., R. 7W., W.M.

SEC. 24

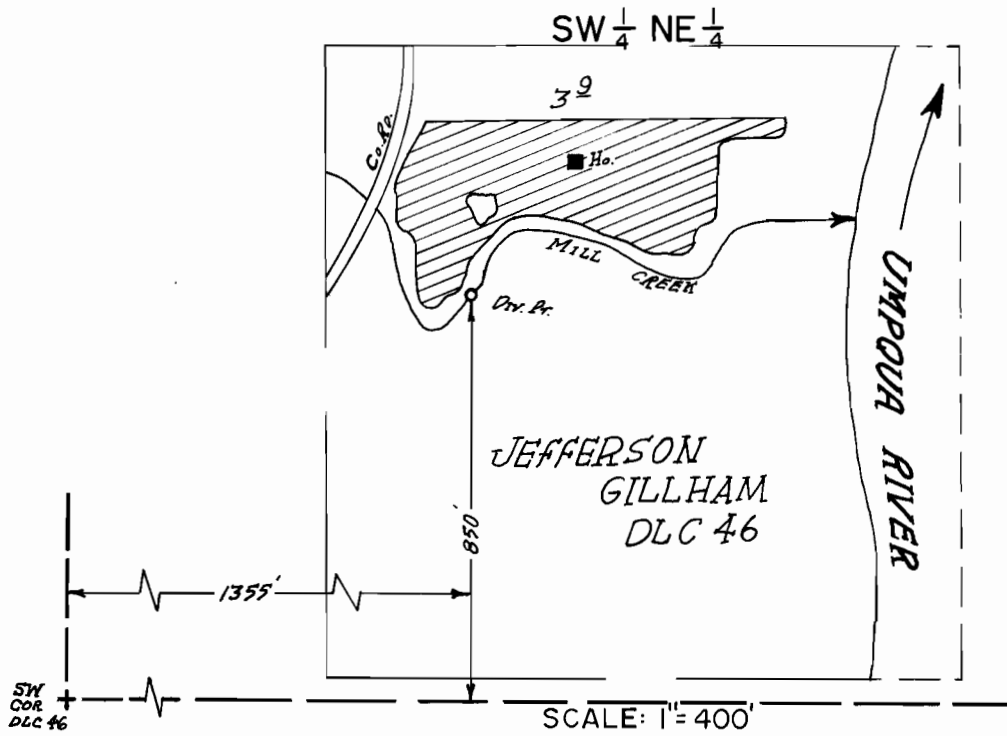

**FINAL PROOF SURVEY**  
UNDER

Application No. 50499.. Permit No. 38133.....  
IN NAME OF

EVERETT O. & ELEANOR L. MOODY...

Surveyed JUNE 20.... 19.79.., by J. S. DONALDSON....