


T.22S. R.7W. W.M.

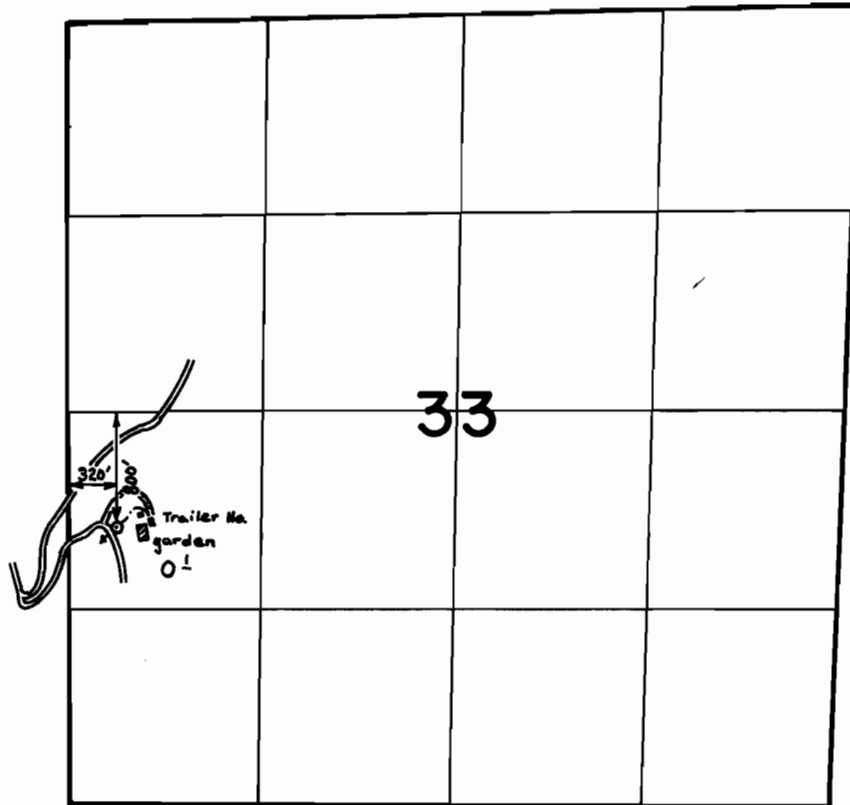

SCALE: 4" = 1 mile

FINAL PROOF SURVEY
UNDER

Application No. 51062 Permit No. 38531
IN NAME OF

JAMES B. & ARVILLA H. HALL

Surveyed Aug. 29, 1979, by S. Donaldson