


T.30S. R.5W. W.M.

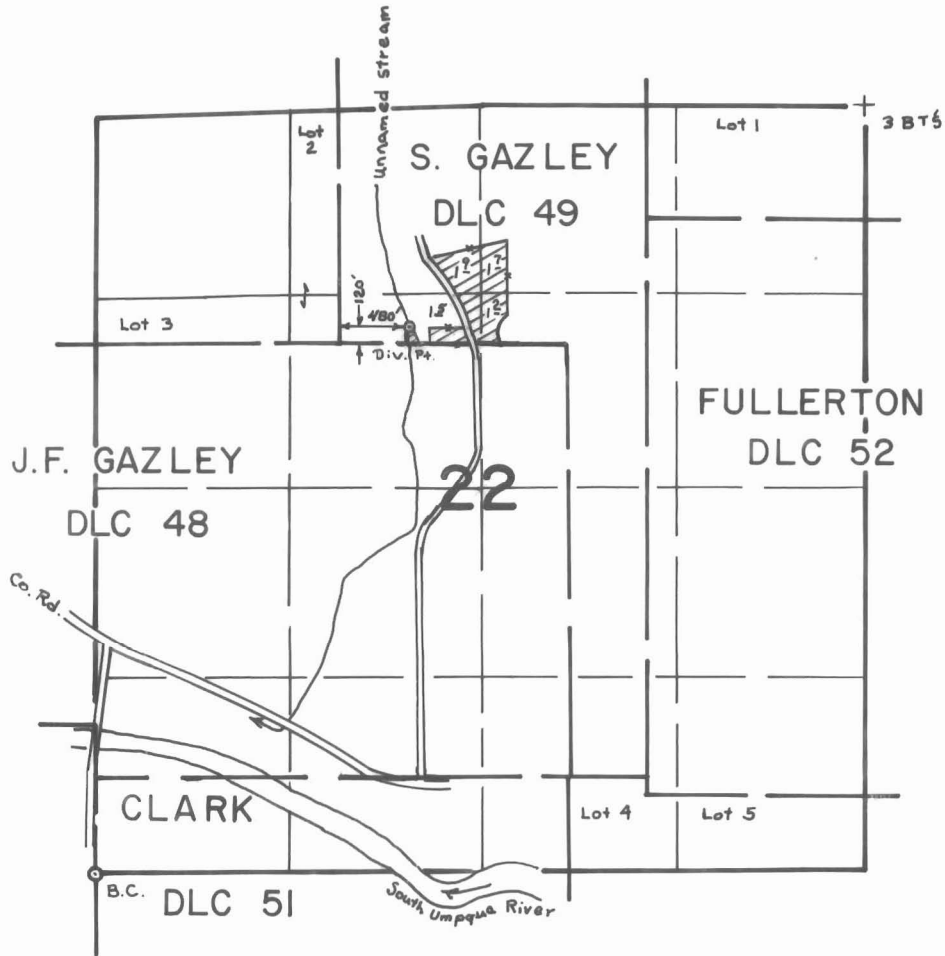

SCALE : 1" = 1320'

**FINAL PROOF SURVEY**  
UNDER

Application No. 52139 Permit No. 39269

IN NAME OF

GEORGE M. ANDERSON

Surveyed March 14 1979, by S. Donaldson