


# T. 28S., R. 7W., W.M.

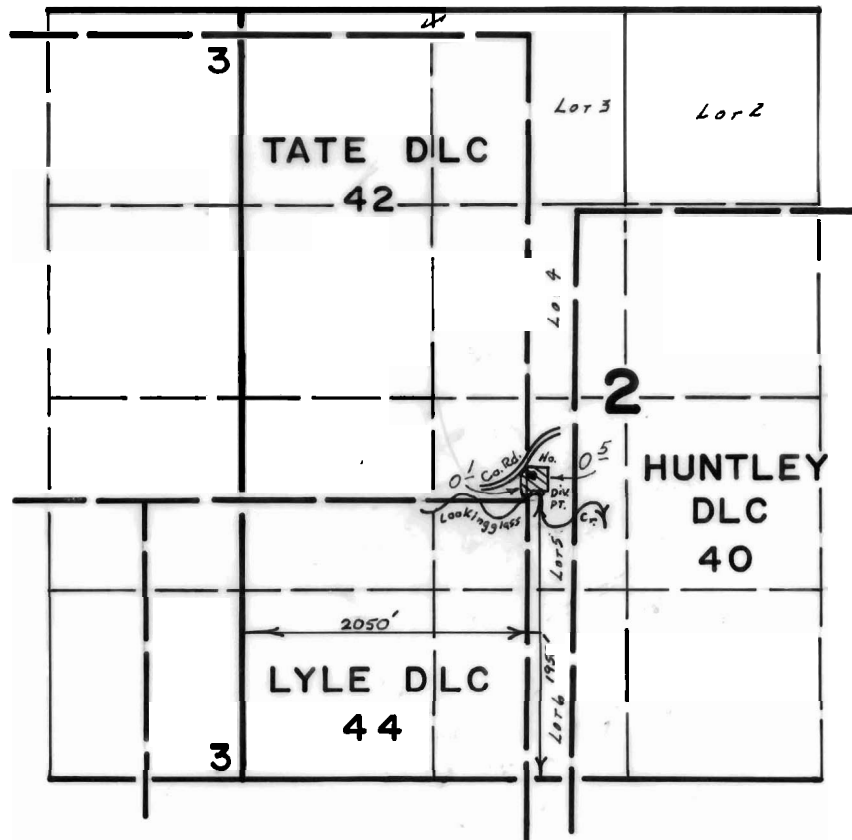

SCALE 4" = 1 mile

## FINAL PROOF SURVEY UNDER

Application No. 5218.7... Permit No. 3.9.295..  
IN NAME OF

.....JAMES...E...&...LEANNA.R...ALLEN

Surveyed June...7., 1979, by S...Donaldson