


T. 26 S. R. 5 W. W.M.

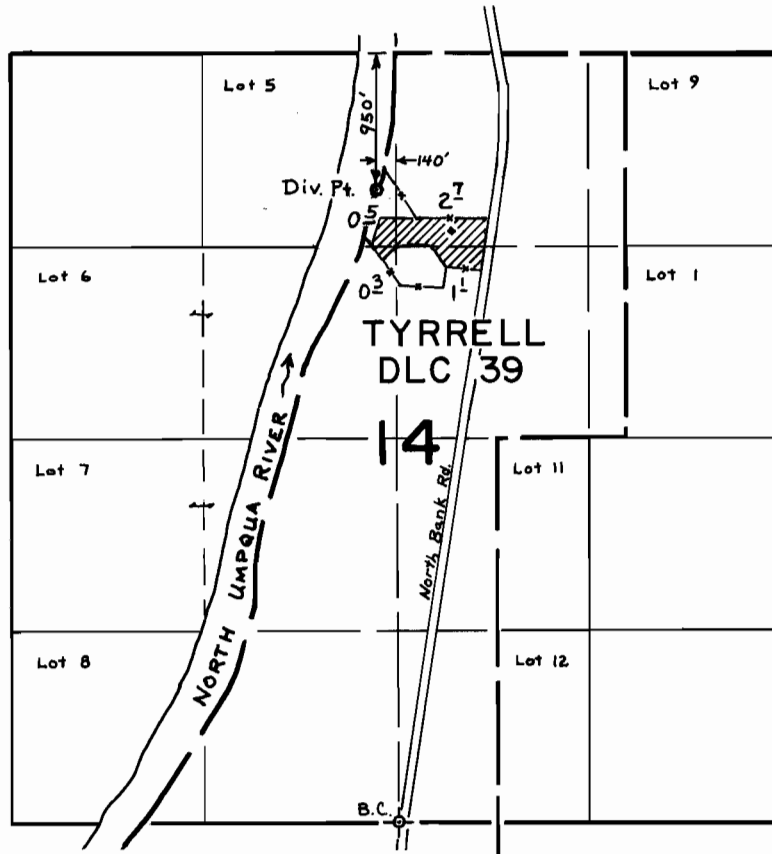

SCALE: 4" = 1 mile

FINAL PROOF SURVEY
UNDER

Application No. 53265.. Permit No. 39528.....
IN NAME OF

.....**FRED W. FERRELL**.....

Surveyed April 30, 1979., by S. Donaldson.....