


T. 22 S., R. 6 W., W. M.

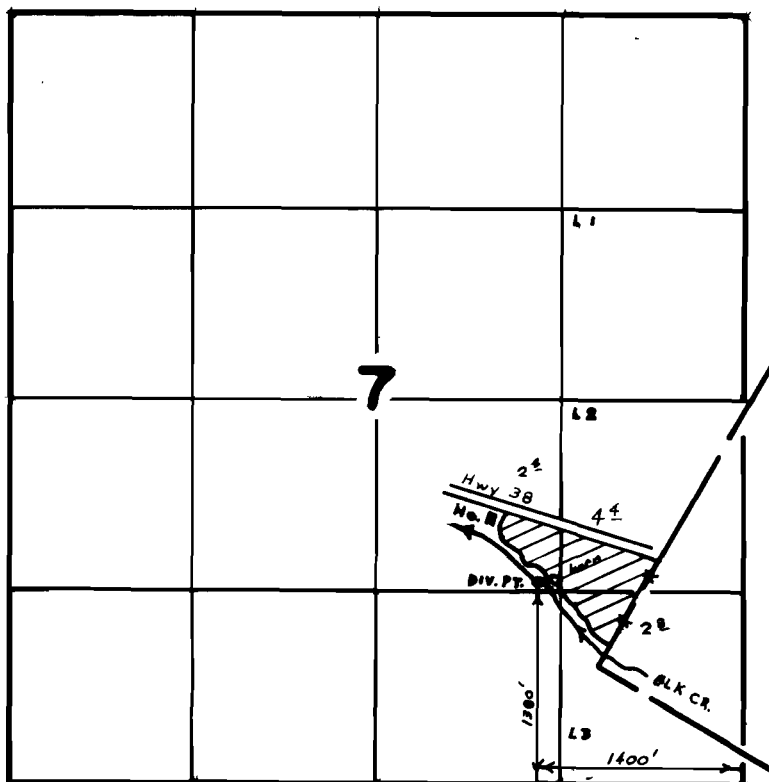

J. DAISLEY
D.L.C. 37

SCALE: 4" = 1 mile

FINAL PROOF SURVEY
UNDER

Application No. 53355.. Permit No. 39585..
IN NAME OF

.....BILL & DONNA BREWSTER

Surveyed SEPT. 6, 1979, by S. DONALDSON