


T.26S., R.6W., W.M.

SEC. 25

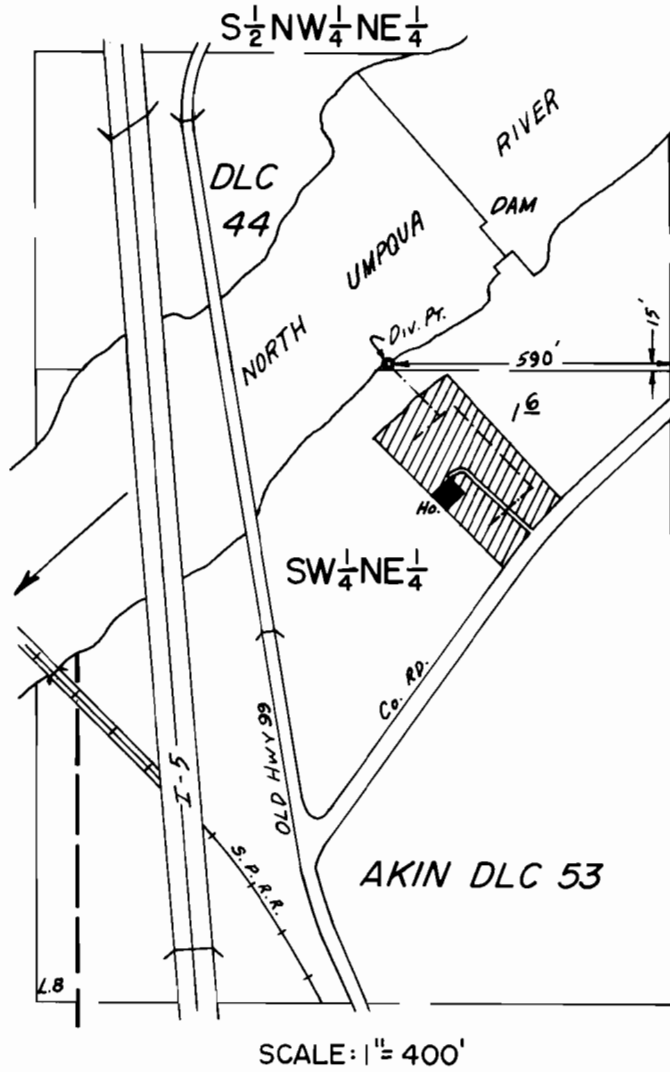

**FINAL PROOF SURVEY**  
UNDER

Application No. 52693 Permit No. 39696  
IN NAME OF

WILEY L. McCRAW

Surveyed June 19, 1979, by J.S. DONALDSON