


T. 30 S., R. 3 W., W.M.

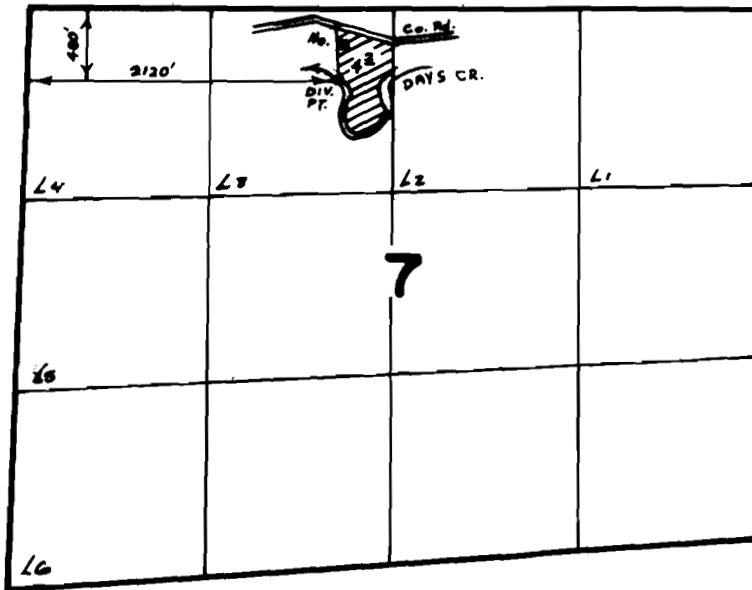

SCALE 4" = 1 mile

FINAL PROOF SURVEY
UNDER

Application No. 53516... Permit No. 4005B.
IN NAME OF

.....MARJORIE.....HOLSCLAW.....

Surveyed March 20, 1979, by S. Donaldson.