


T.27S. R.7W. W.M.

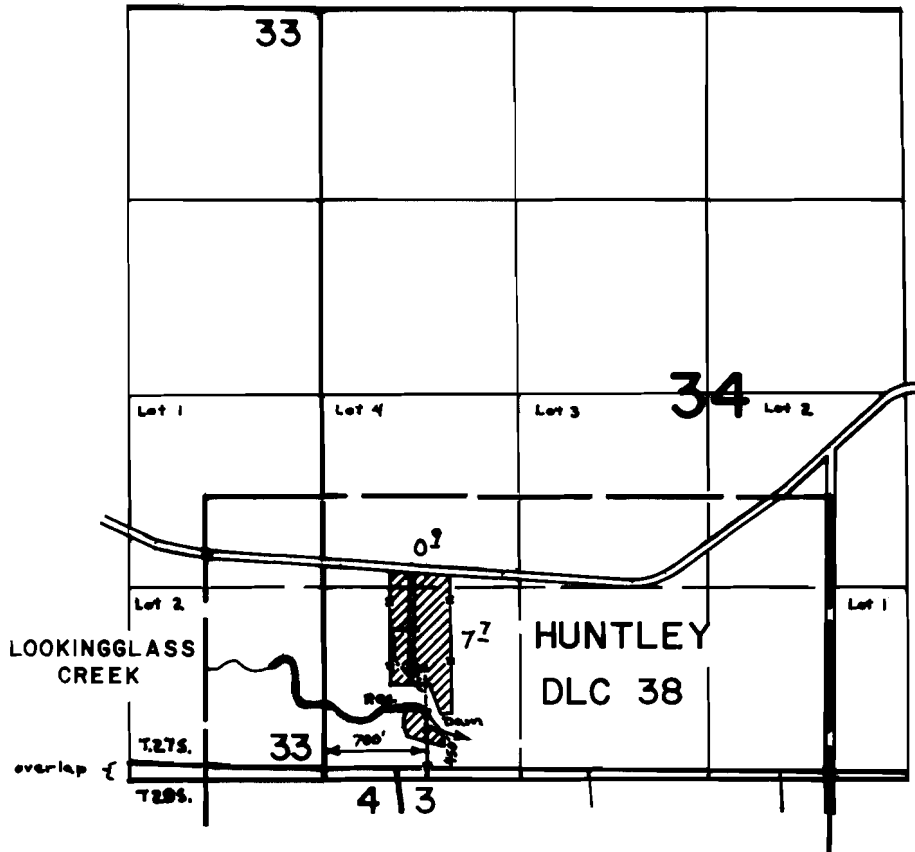

SCALE: 4" = 1 mile

FINAL PROOF SURVEY

UNDER

53550

40077

R-55845

R-6749

Application No. 55846... Permit No. 42559...

IN NAME OF

ALVIN D. & CHARLOTTE BOWLIN

Jan. 26 1979

D. Henry

Surveyed June 21, 1979, by S. Donaldson.

MAR. 19-20, 1986, J.M. SCHMORDE