


T.22S. R.8W. W.M.

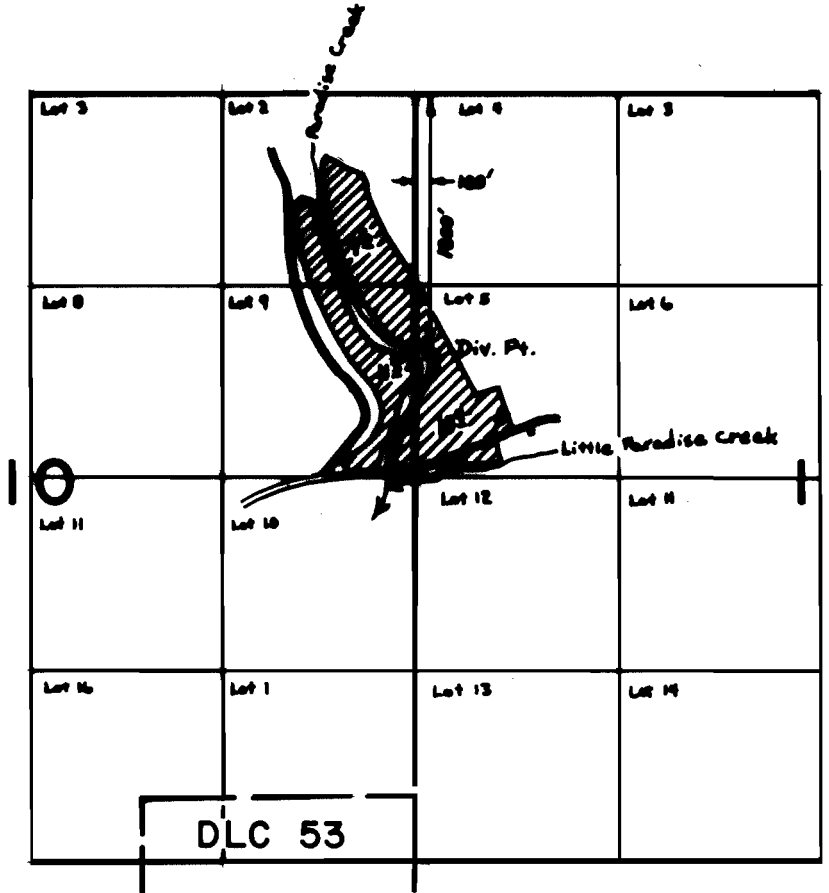

SCALE : 4" = 1 mile

**FINAL PROOF SURVEY  
UNDER**

Application No. 54312 Permit No. 40666  
IN NAME OF

PARADISE CREEK RANCH

Surveyed Sept. 5, 1979, by S. Donaldson...