


T. 26S., R. 5W., W.M.

SEC. 23

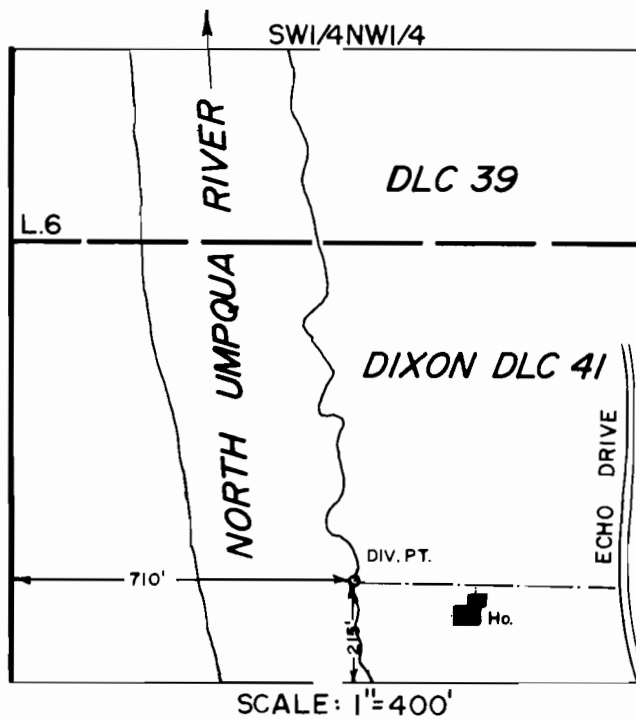

FINAL PROOF SURVEY
UNDER

Application No. 54751... Permit No. 41071.....
IN NAME OF

.....DONALD S. SMITH.....

Surveyed May 2..... 1979, by J.S. DONALDSON