

T. 10. S. R. 39. E.

T. 10. S. R. 40. E.


25

T 10 S R 39 E

T 10 S R 40 E

30

TOWNSHIP LINE

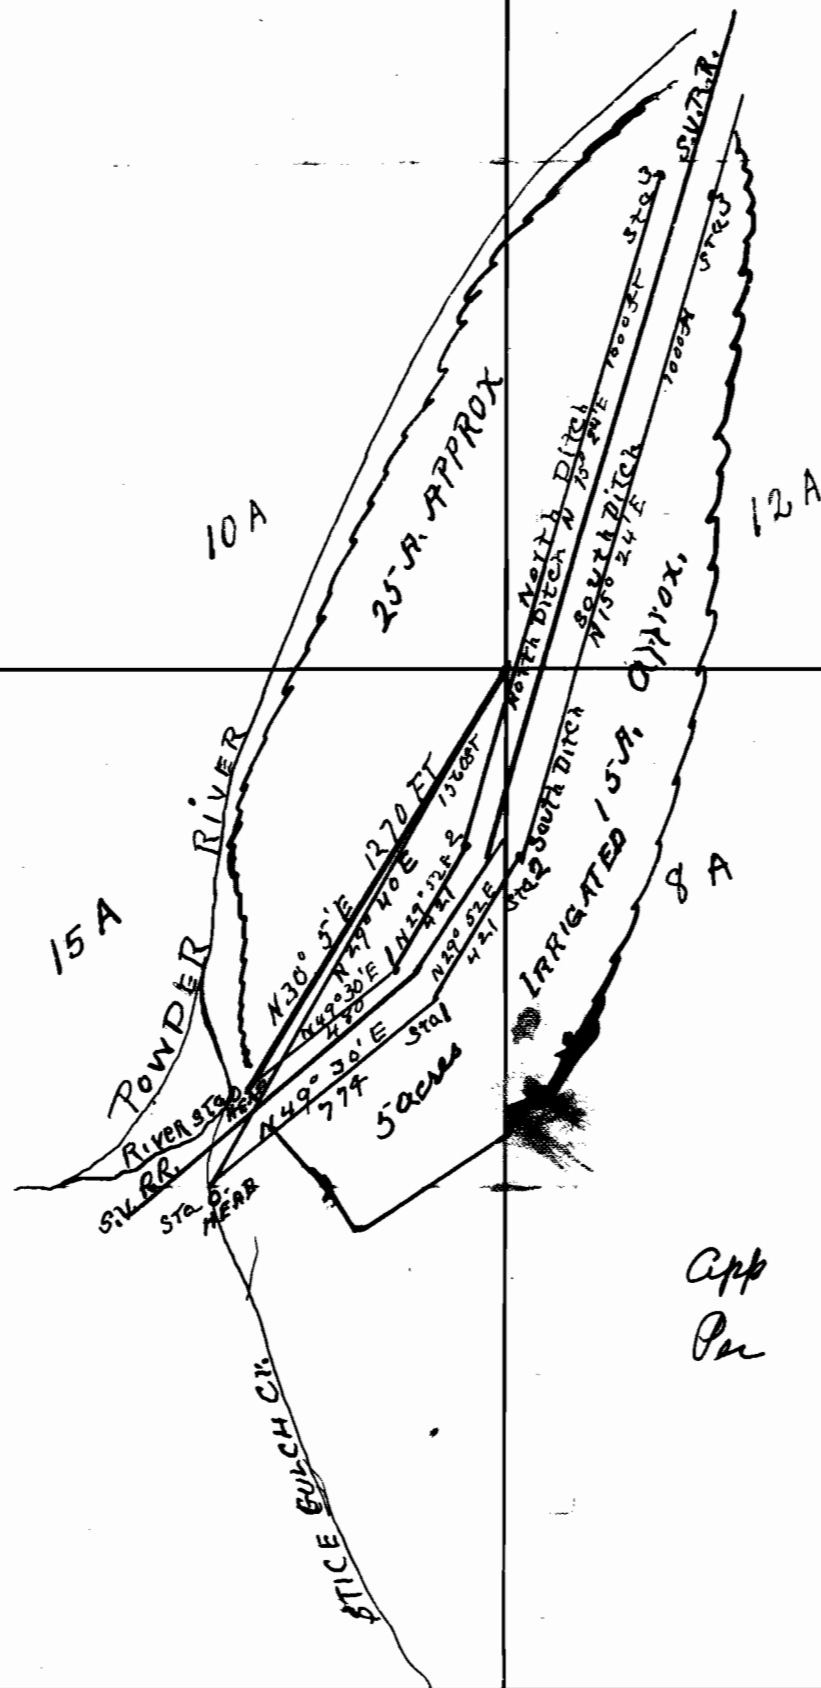

App 9142
Per 6000

CERTIFICATE OF SURVEYOR.

I D.W.C. NELSON OF BAKER, OREGON, DO HEREBY CERTIFY THAT THIS MAP WAS MADE FROM NOTES TAKEN DURING AN ACTUAL SURVEY MADE BY ME ON THE 29 DAY OF JUNE 1925, AND THAT IT CORRECTLY REPRESENTS THE WORKS DESCRIBED IN THE ACCOMPANYING APPLICATION, TOGETHER WITH THE LOCATION OF STREAMS IN THE IMMEDIATE LOCALITY.

D.W.C. NELSON SURVEYOR.



STATE ENGINEER RECEIVED

JUN 30 1925

BAKER, OREGON

Application No. 9142
Permit No. 6000