


T. 26S., R. 5W., W.M.

23

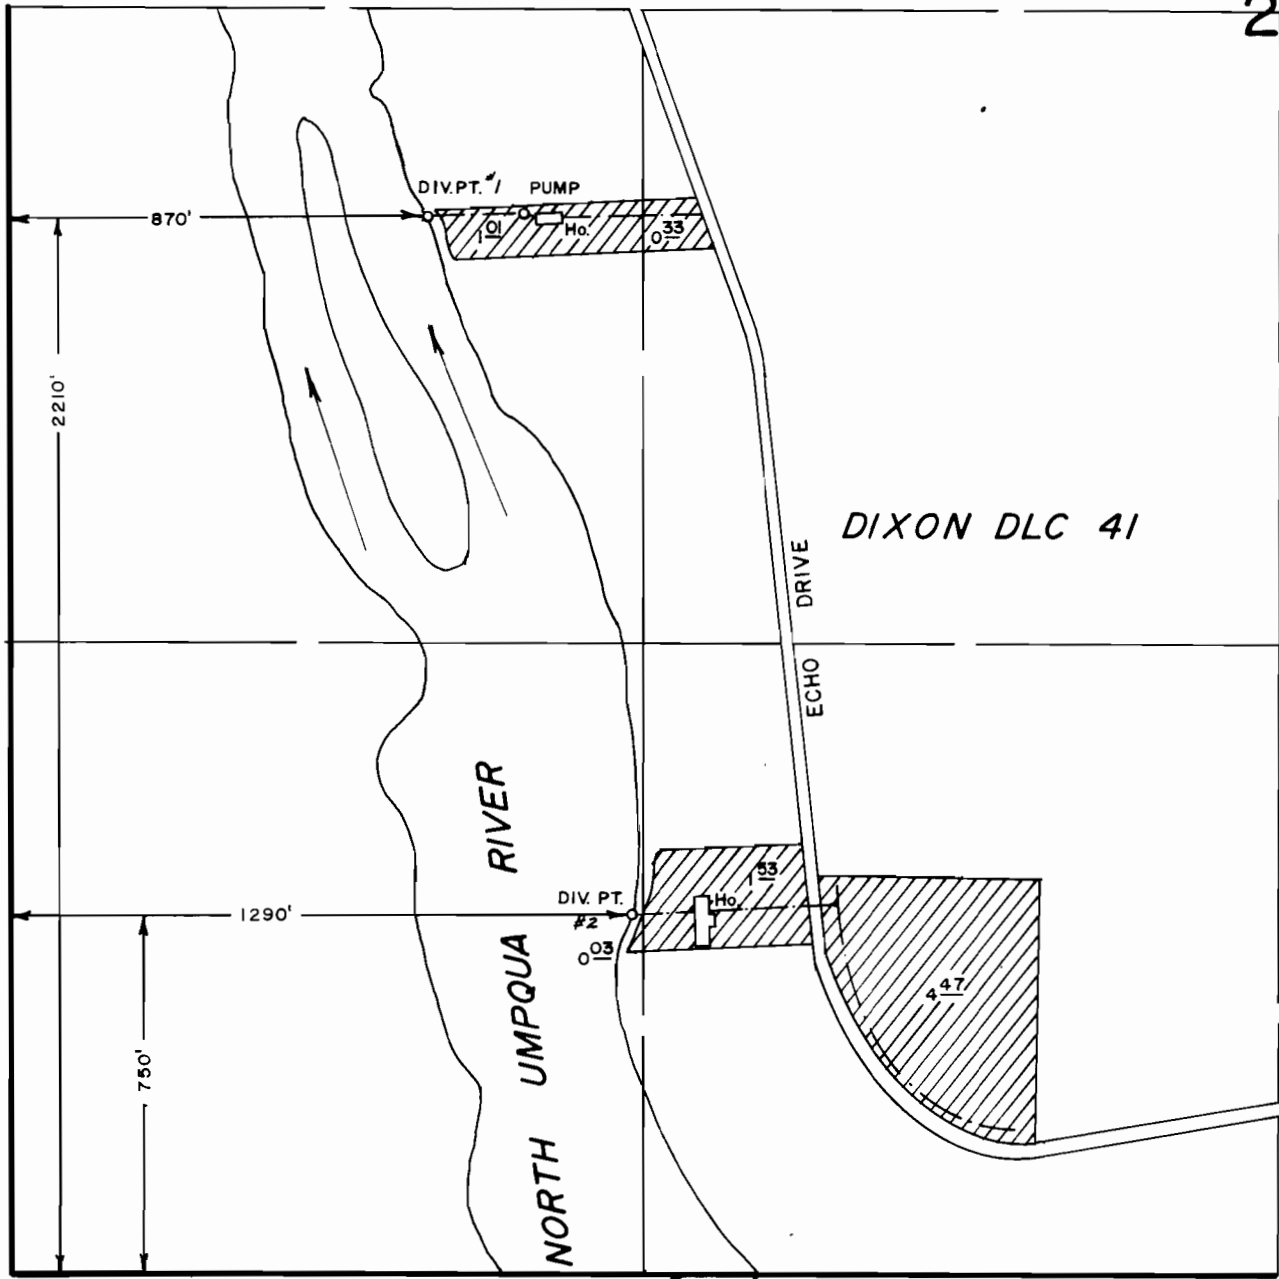

SCALE: 1" = 400'

FINAL PROOF SURVEY
UNDER

Application No. 54781..... Permit No. 41104.....

IN NAME OF

BRIAN E. & CONNIE A. McKEE.....

Surveyed MAY 7..... 19..79, by J.S. RONALDSON.....