


T.23S. R.4W. W.M.

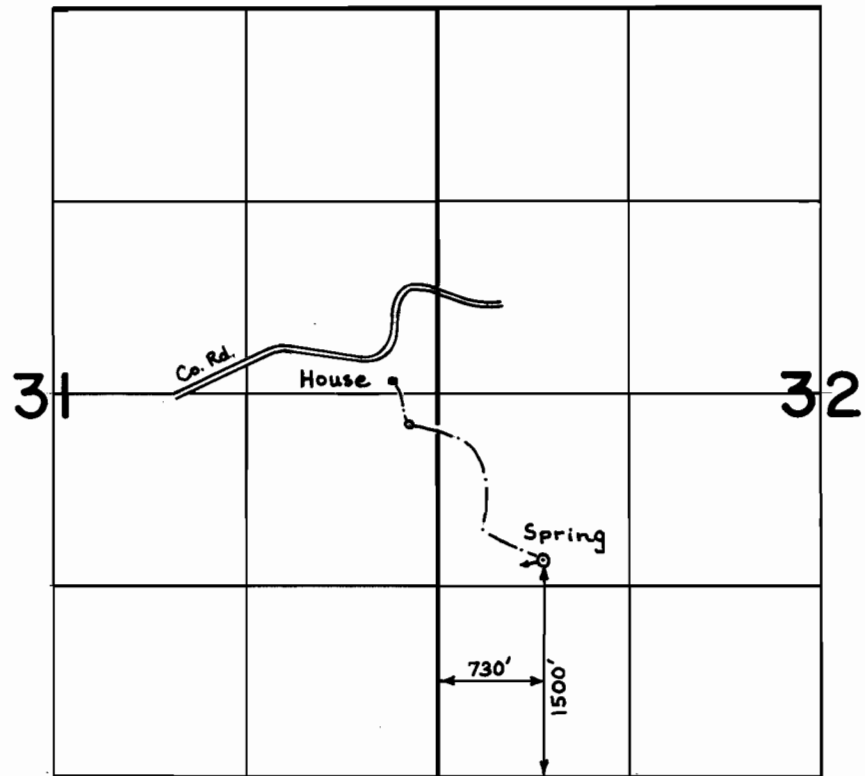

SCALE: 4 = 1 mile

FINAL PROOF SURVEY
UNDER

Application No. 55080 Permit No. 41325
IN NAME OF

Mr. & Mrs. RICHARD NIX

Surveyed Oct. 3, 1979, by S. Donaldson.