


T.22S. R.8W. W.M.

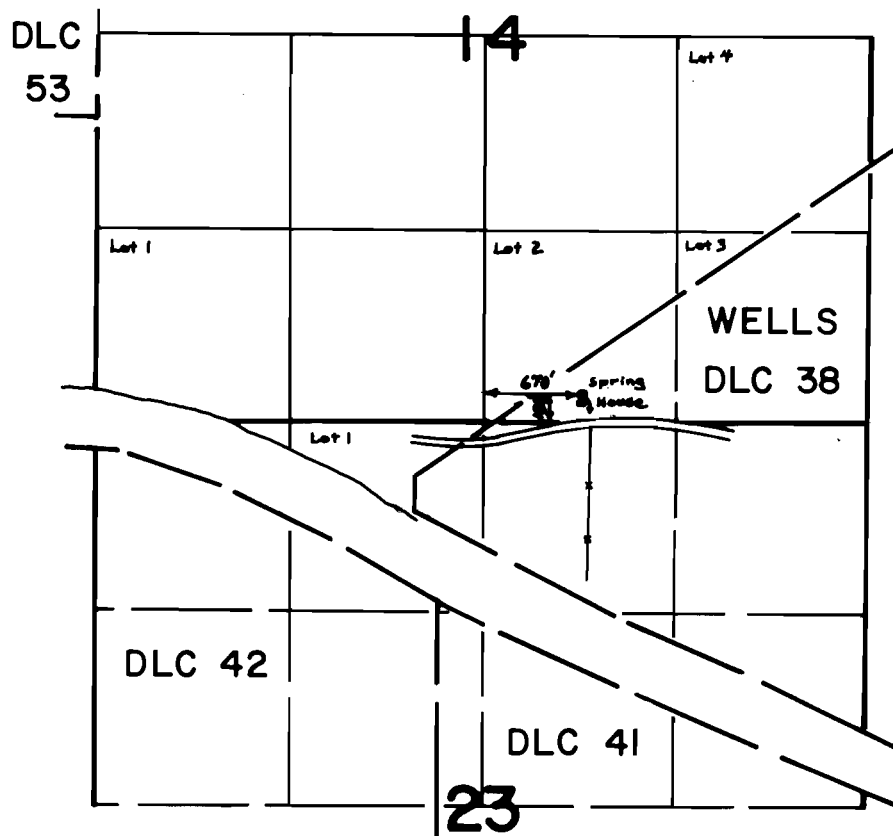

SCALE: 4" = 1 mile

FINAL PROOF SURVEY
UNDER

Application No. 55348 Permit No. 41497
IN NAME OF

JOHN EDWARD CAIG

Surveyed Sept. 4, 1979, by S. Donaldson.