


T. 26S., R. 7W., W.M.

SEC. 35

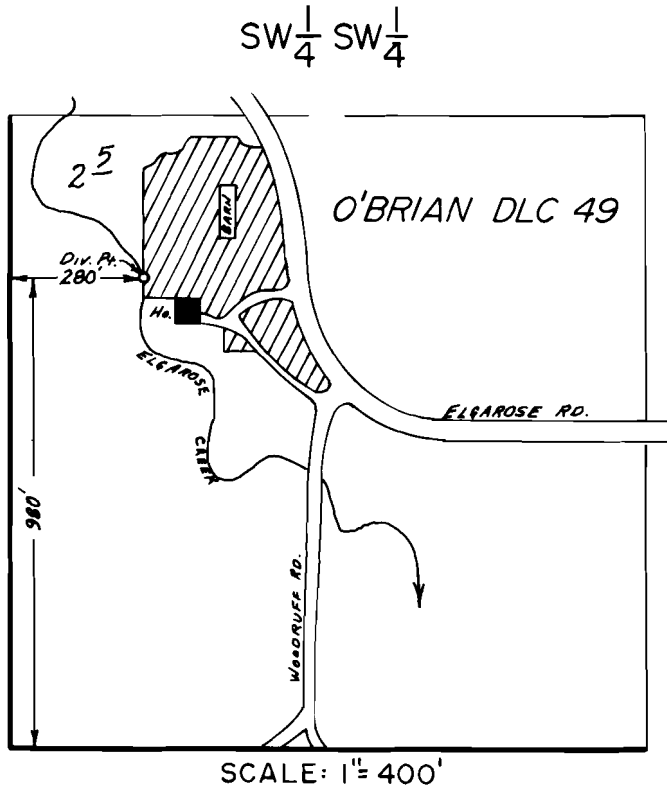

FINAL PROOF SURVEY
UNDER

Application No. 55679. Permit No. 41711.....

IN NAME OF

.....DONALD K. NEFF.....

Surveyed MAY 7, 1979, by J.S. DONALDSON